



15/FL
11,945 sf

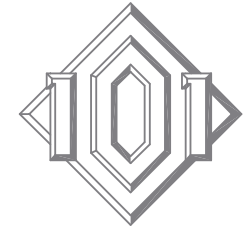

101 CALIFORNIA

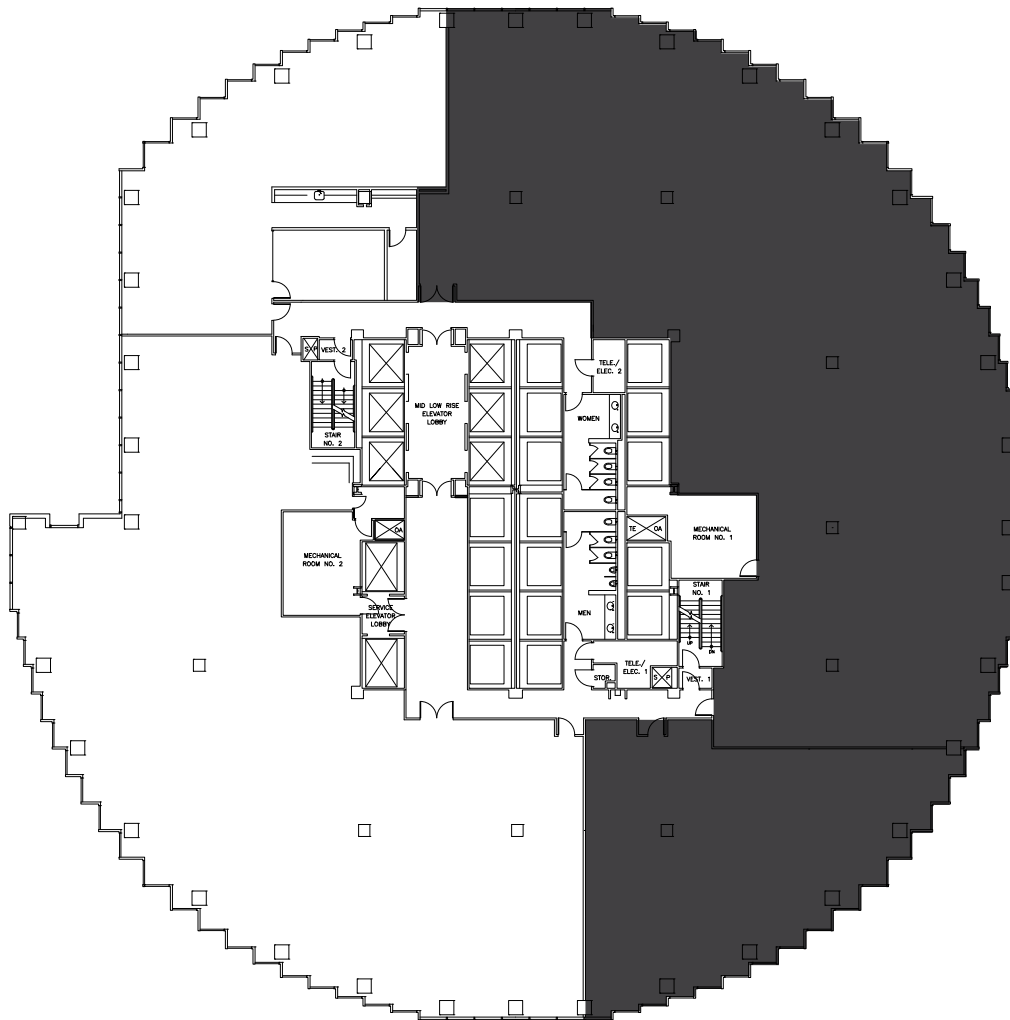

As Built Plan

- Partially built with high-end improvements and elevator identity
- Mainly open with 1 large conference room, 1 kitchen/production area, and server room
- Expansive cityscape views
- Divisible to 3,107 sf
- Available immediately

Contacts

David Eaton & Ryan Lowe
david.eaton@hines.com
ryan.lowe@hines.com
101 California Street, Suite 100
San Francisco, CA 94105
415.982.6200



Hines