



17/FL
3,269 sf

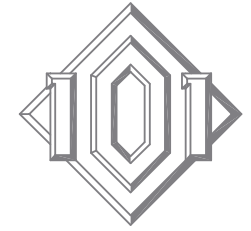

101 CALIFORNIA

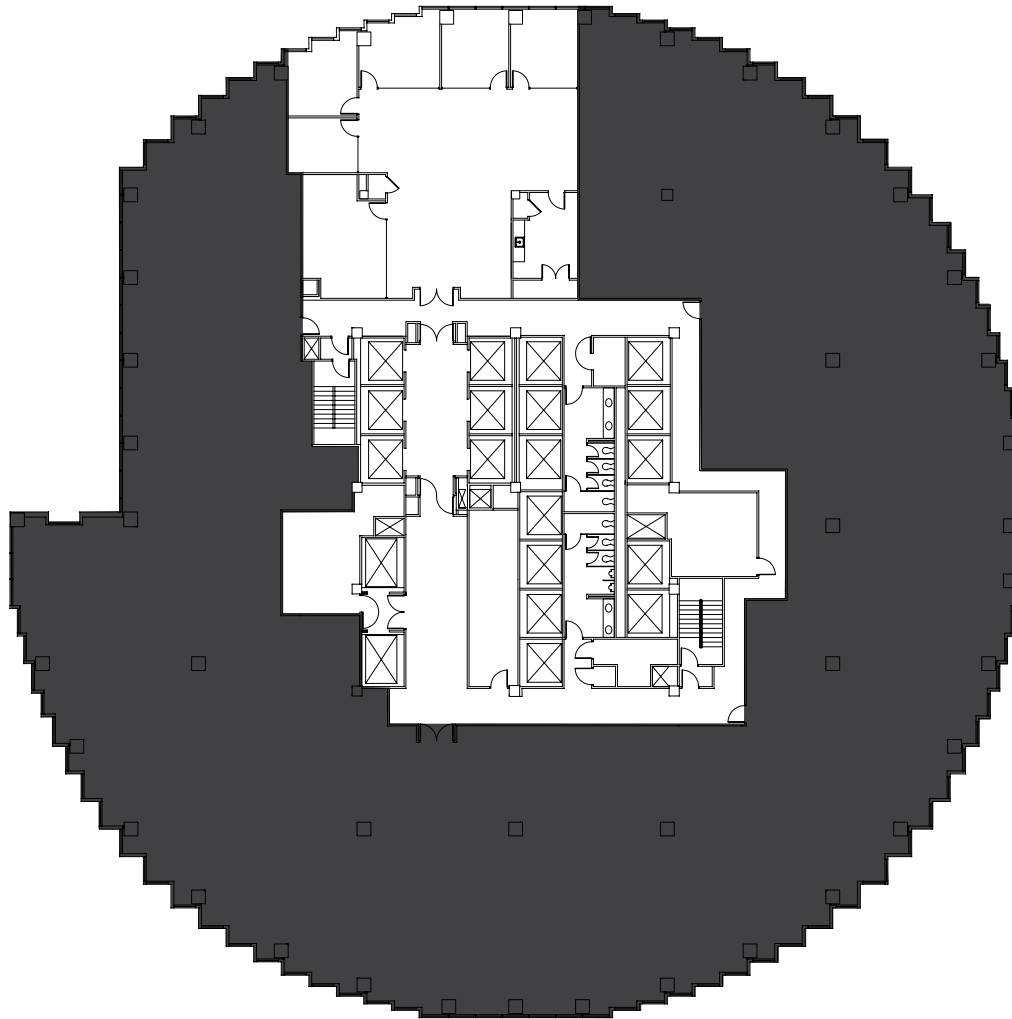

As Built Plan

- Pre-built suite
- 5 perimeter offices, 1 perimeter conference room, 1 kitchen/production area and telecom closet
- Cityscape and Bay views
- Available immediately

Contacts

David Eaton & Ryan Lowe
david.eaton@hines.com
ryan.lowe@hines.com
101 California Street, Suite 100
San Francisco, CA 94111
415.982.6200
www.101california.com



Hines