



19/FL
4,005 sf

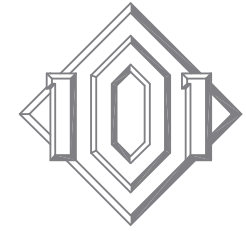

101 CALIFORNIA

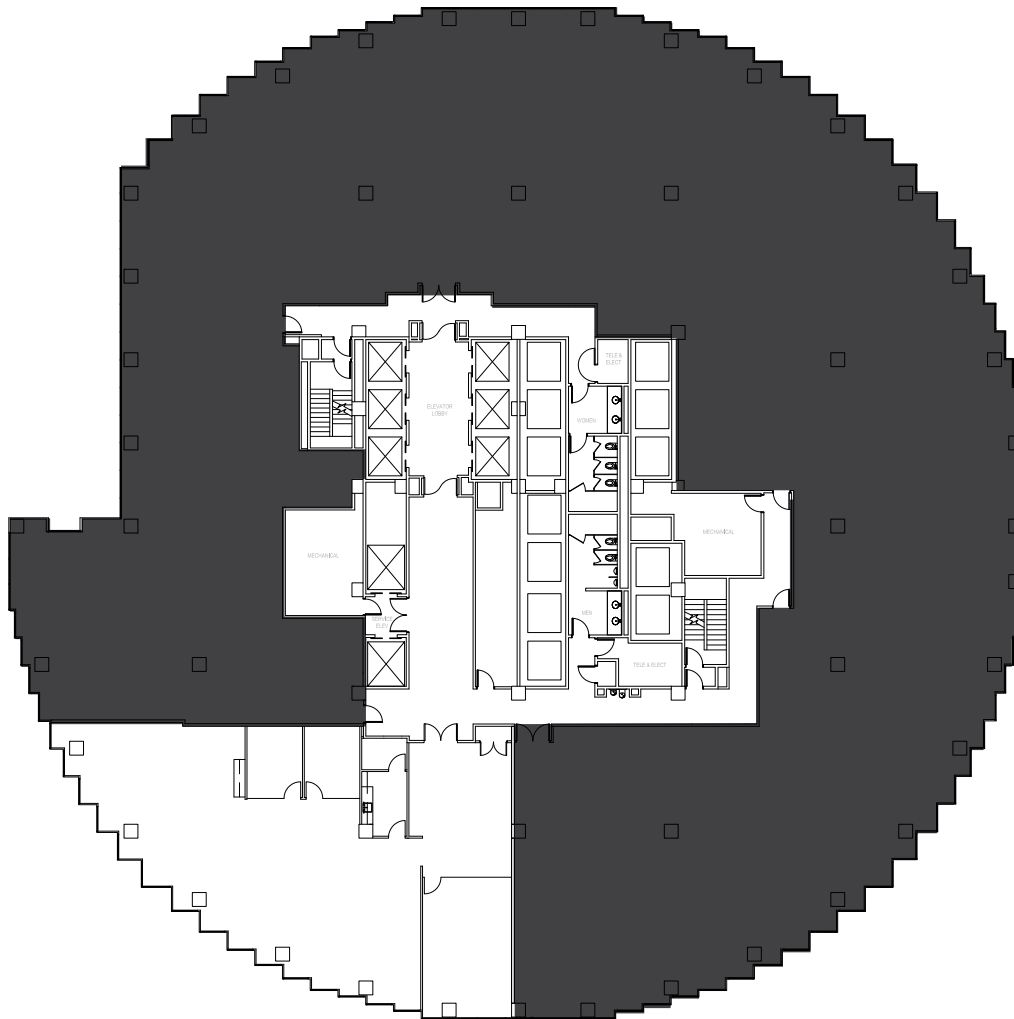

As Built Plan

- Planned pre-built suite
- 1 perimeter conference room, 2 interior offices, 1 kitchen, 1 telecom closet, substantial open area, reception
- Available February 1, 2015

Contacts

David Eaton & Ryan Lowe
david.eaton@hines.com
ryan.lowe@hines.com
101 California Street, Suite 1000
San Francisco, CA 94111
415.982.6200
www.101california.com



Hines