



28/FL
3,124 sf

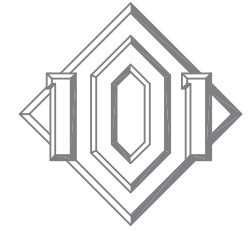

101 CALIFORNIA

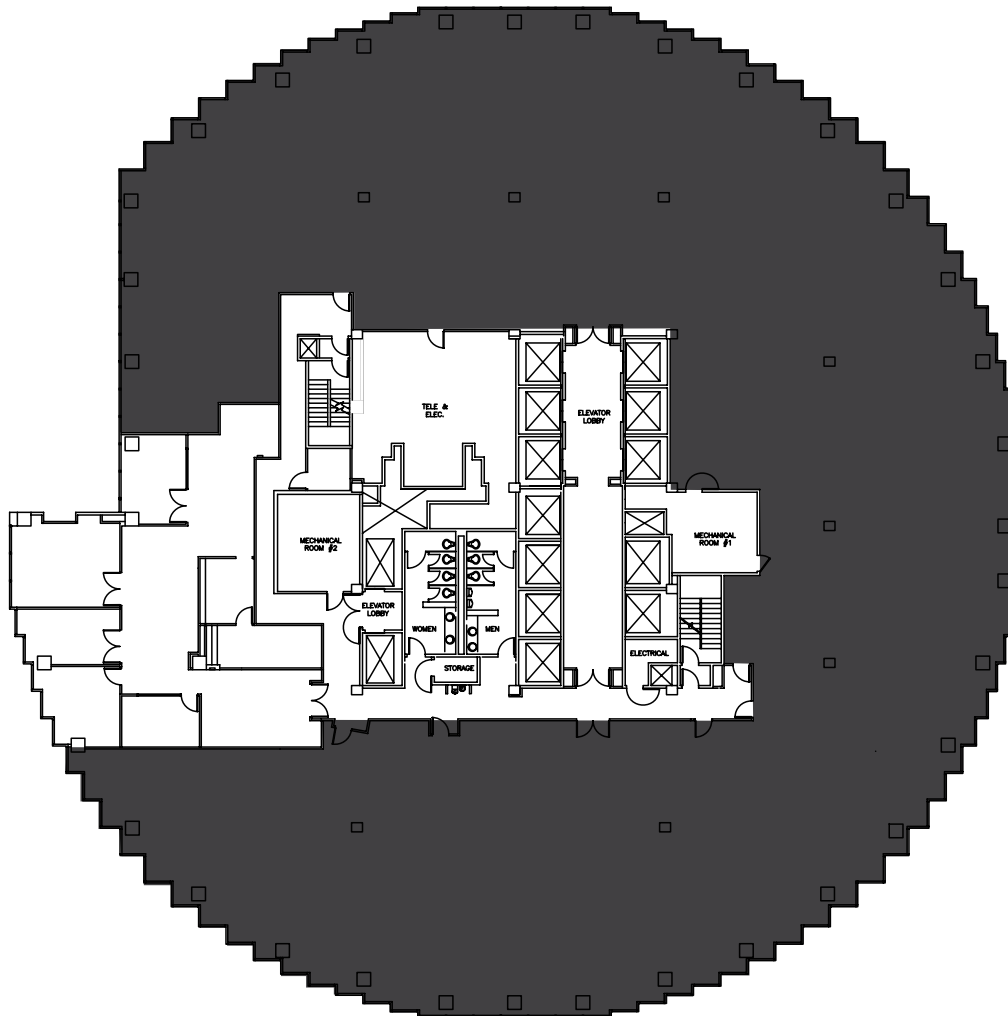

As Built Plan

- Pre-built suite
- 3 perimeter offices, 1 interior office, 1 perimeter conference room, 1 kitchen/production area
- Exceptional views of the Golden Gate Bridge, Mt. Tam, Angel Island, and San Francisco Bay
- Available December 1, 2014

Contacts

David Eaton & Ryan Lowe
david.eaton@hines.com
ryan.lowe@hines.com
101 California Street, Suite 1000
San Francisco, CA 94111
415.982.6200
www.101california.com



Hines