



30/FL
10,659 sf

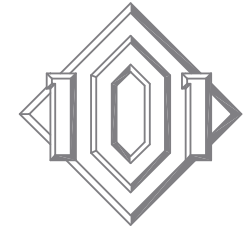

101 CALIFORNIA

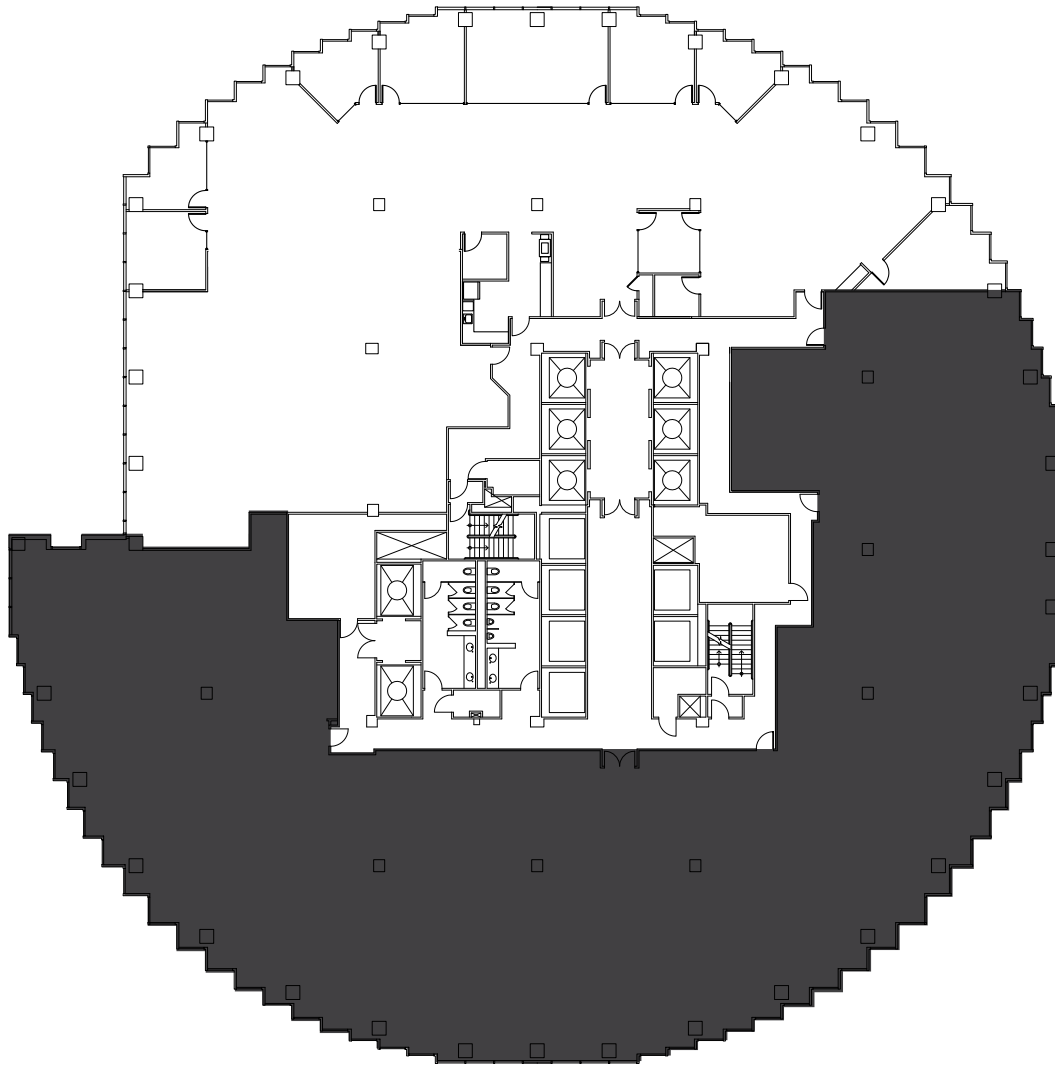

As Built Plan

- Partially built with high-end improvements and elevator identity
- 2 large conference rooms, 1 small conference room, 6 private offices, 1 kitchen/production area, and telecom closet
- Panoramic views of the Golden Gate Bridge, Bay Bridge, Mt. Tam, Alcatraz, Coit Tower, and the Pacific Ocean
- Available immediately

Contacts

David Eaton & Ryan Lowe
david.eaton@hines.com
ryan.lowe@hines.com
101 California Street, Suite 100
San Francisco, CA 94111
415.982.6200
www.101california.com

Hines