


FLOOR 11

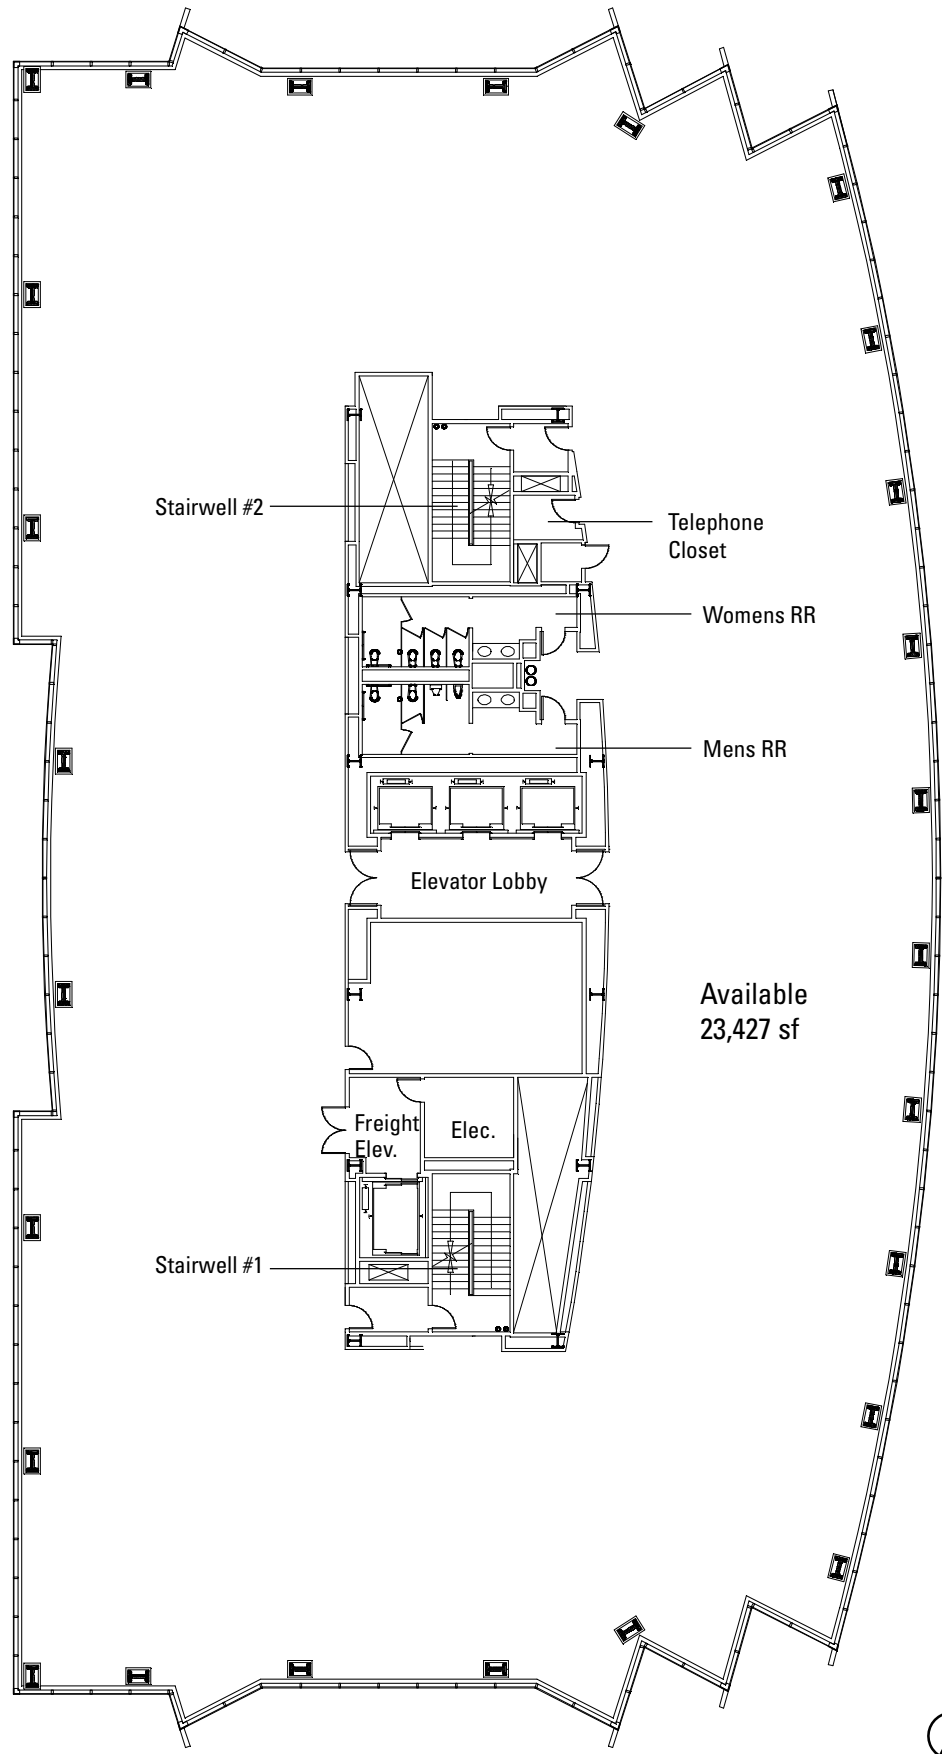

Stairwell #2

Telephone Closet

Womens RR

Mens RR

Elevator Lobby

Available
23,427 sf

Freight Elev.

Elec.

Stairwell #1




2100
POWELL
EMERYVILLE



Hines

FLOOR 11 : As Built Plan

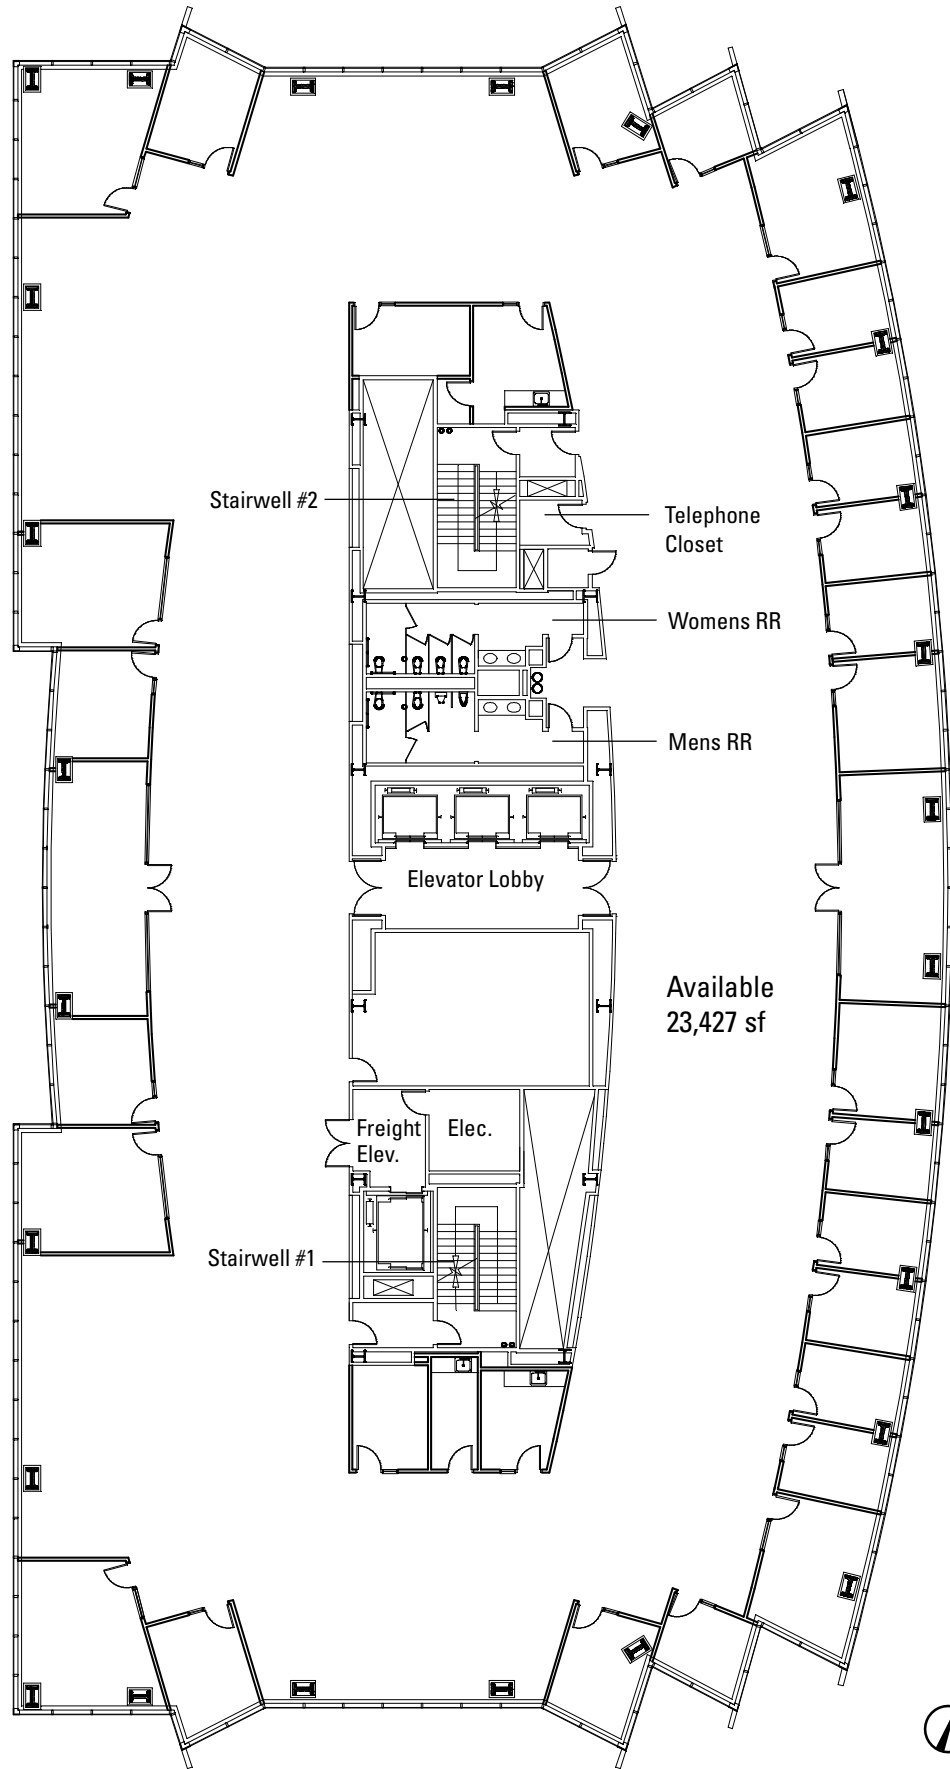

Available
23,427 sf

2100
POWELL
EMERYVILLE



Hines