


FLOOR 12




2100
POWELL
EMERYVILLE

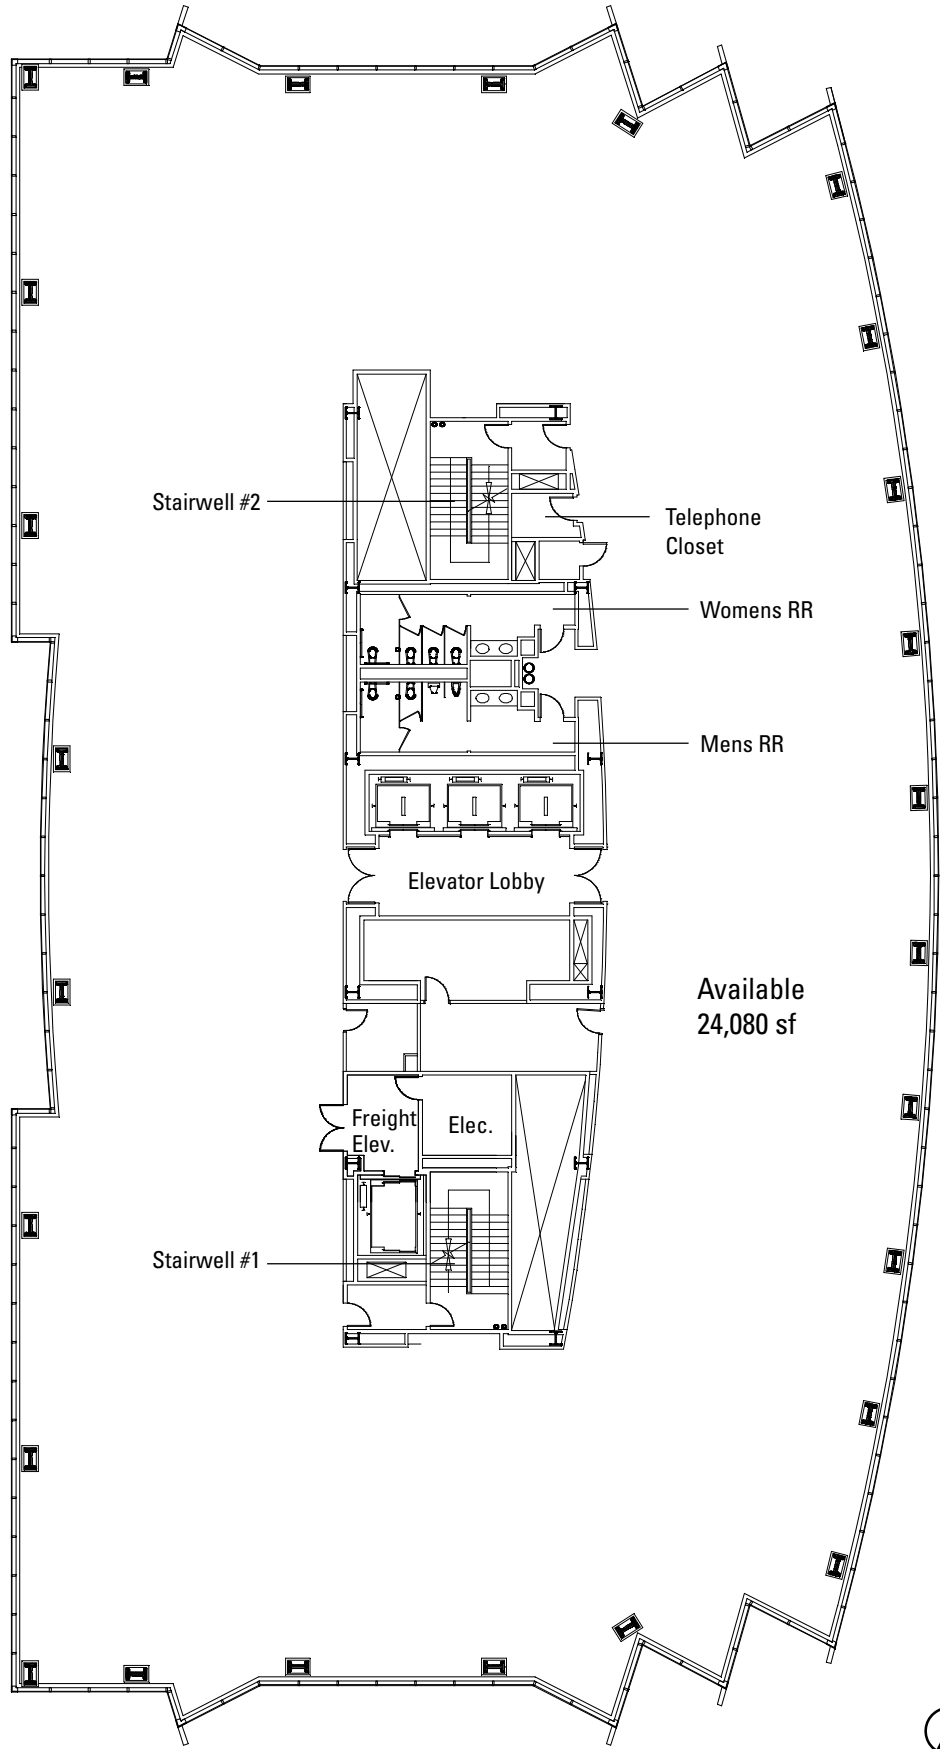

Hines

FLOOR 12 : As Built Plan

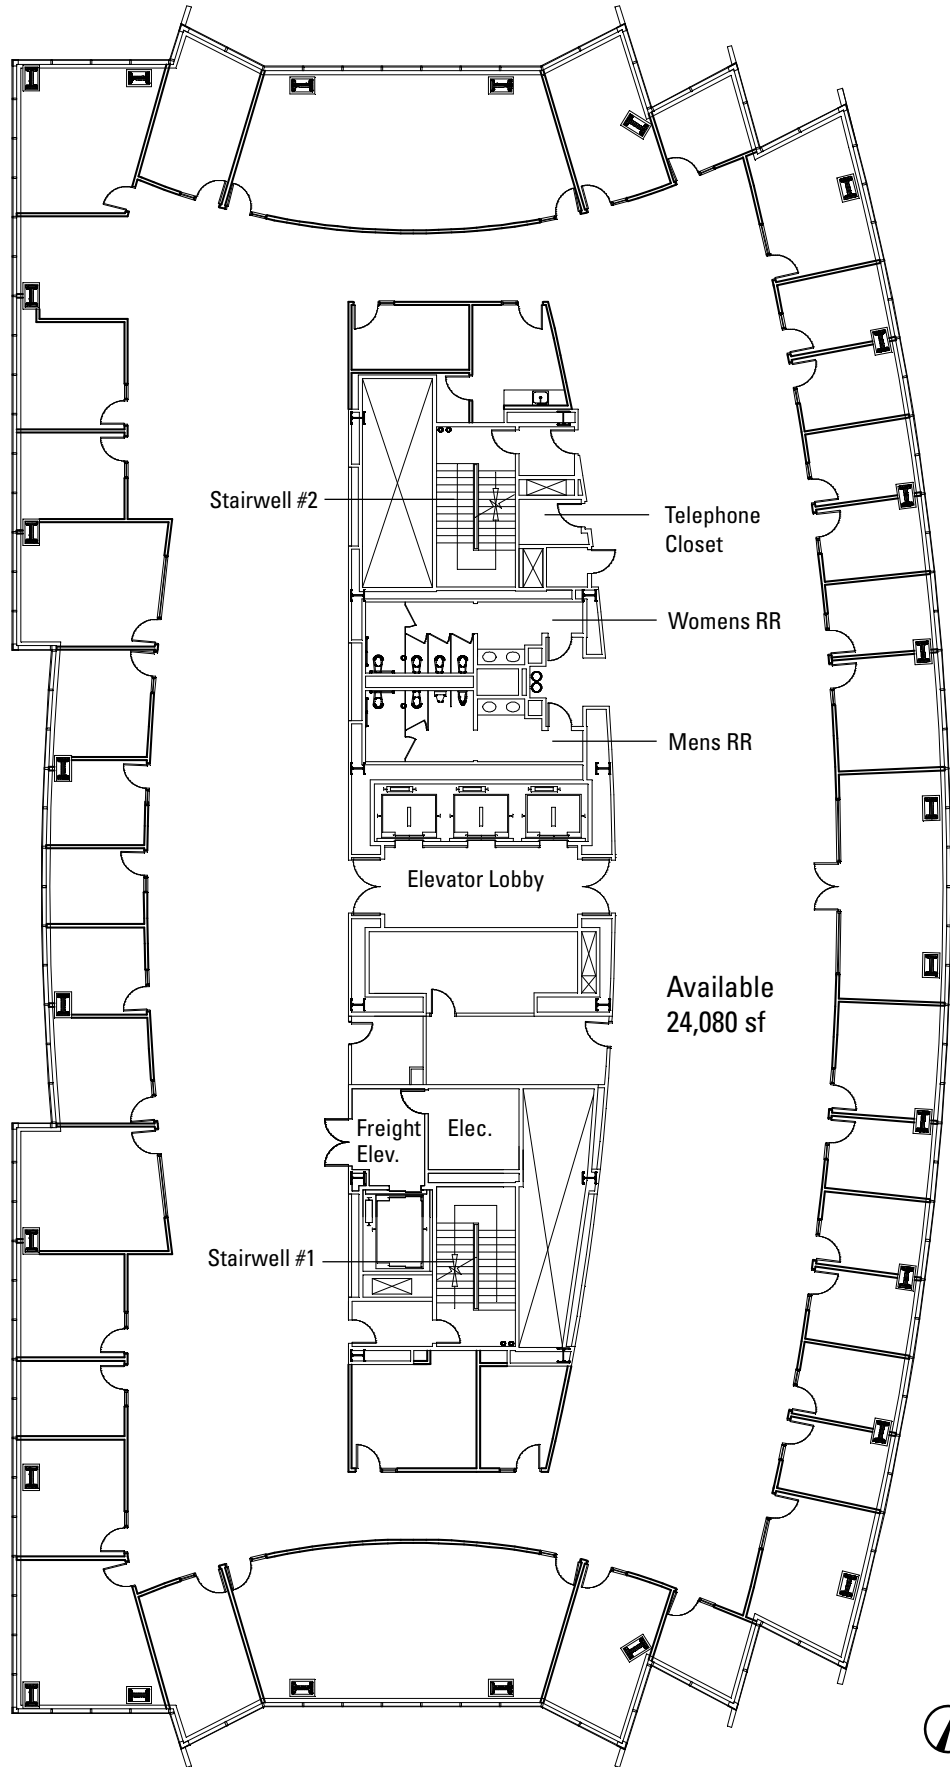

Stairwell #2

Telephone Closet

Womens RR

Mens RR

Elevator Lobby

Available
24,080 sf

Freight Elev.
Elec. Elev.

Stairwell #1



2100
POWELL
EMERYVILLE



Hines