


FLOOR 14




**2100**  
**POWELL**  
EMERYVILLE

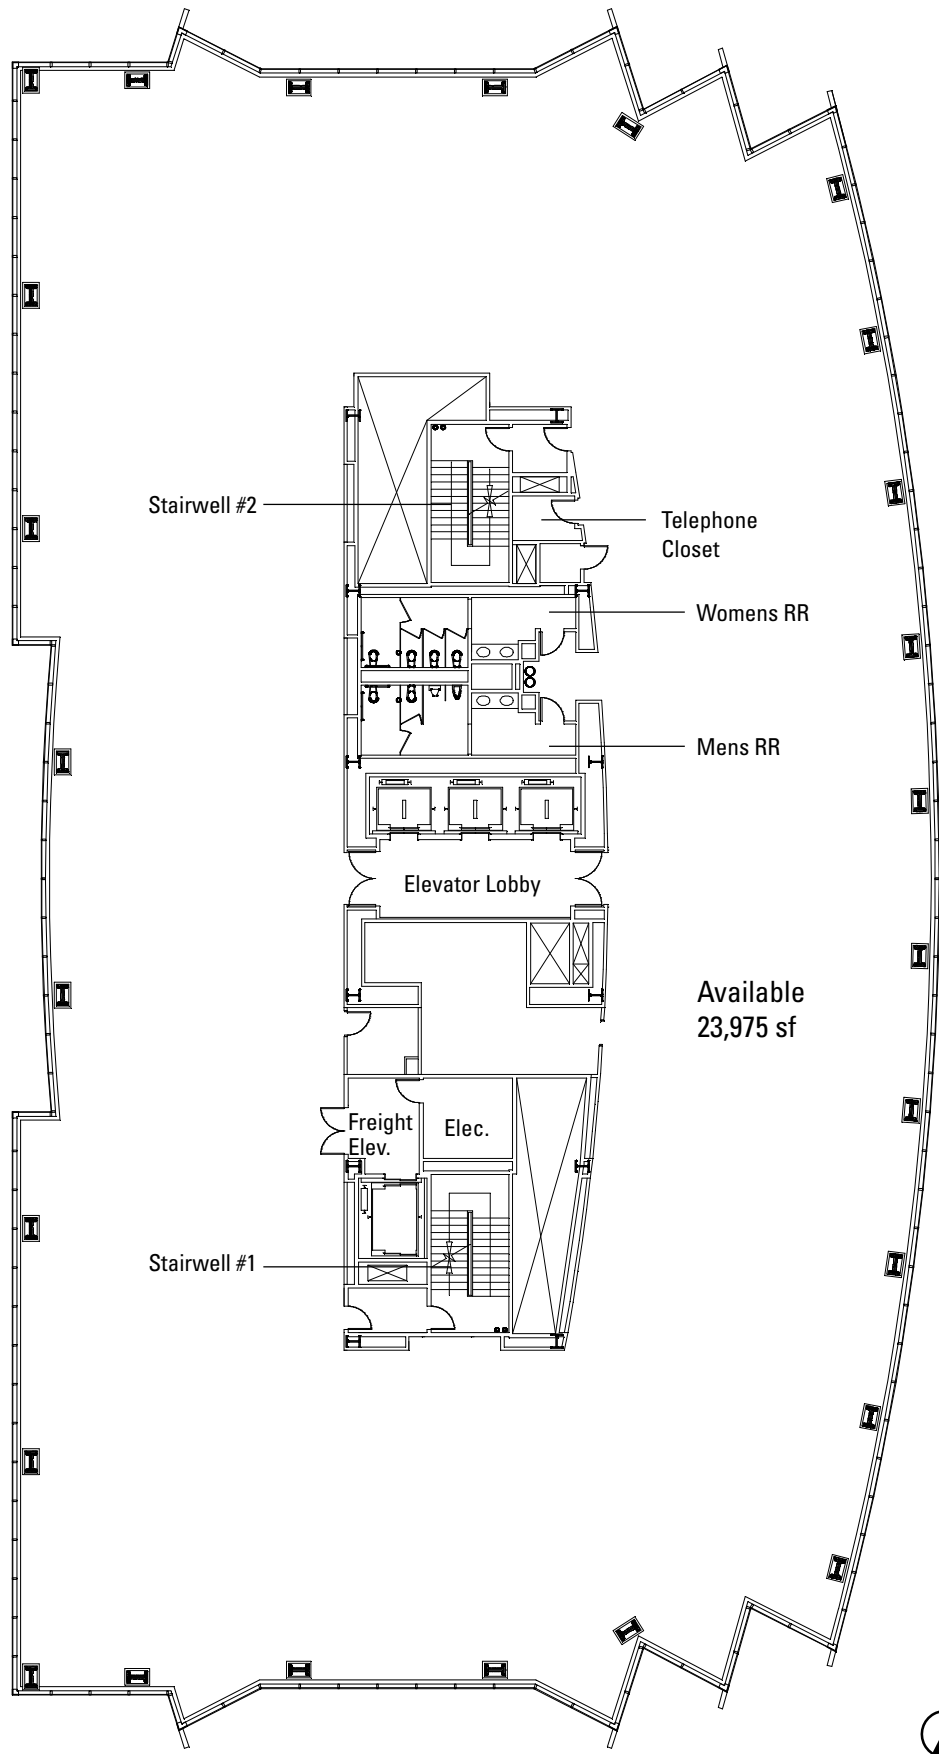

**Hines**

FLOOR 14 : As Built Plan

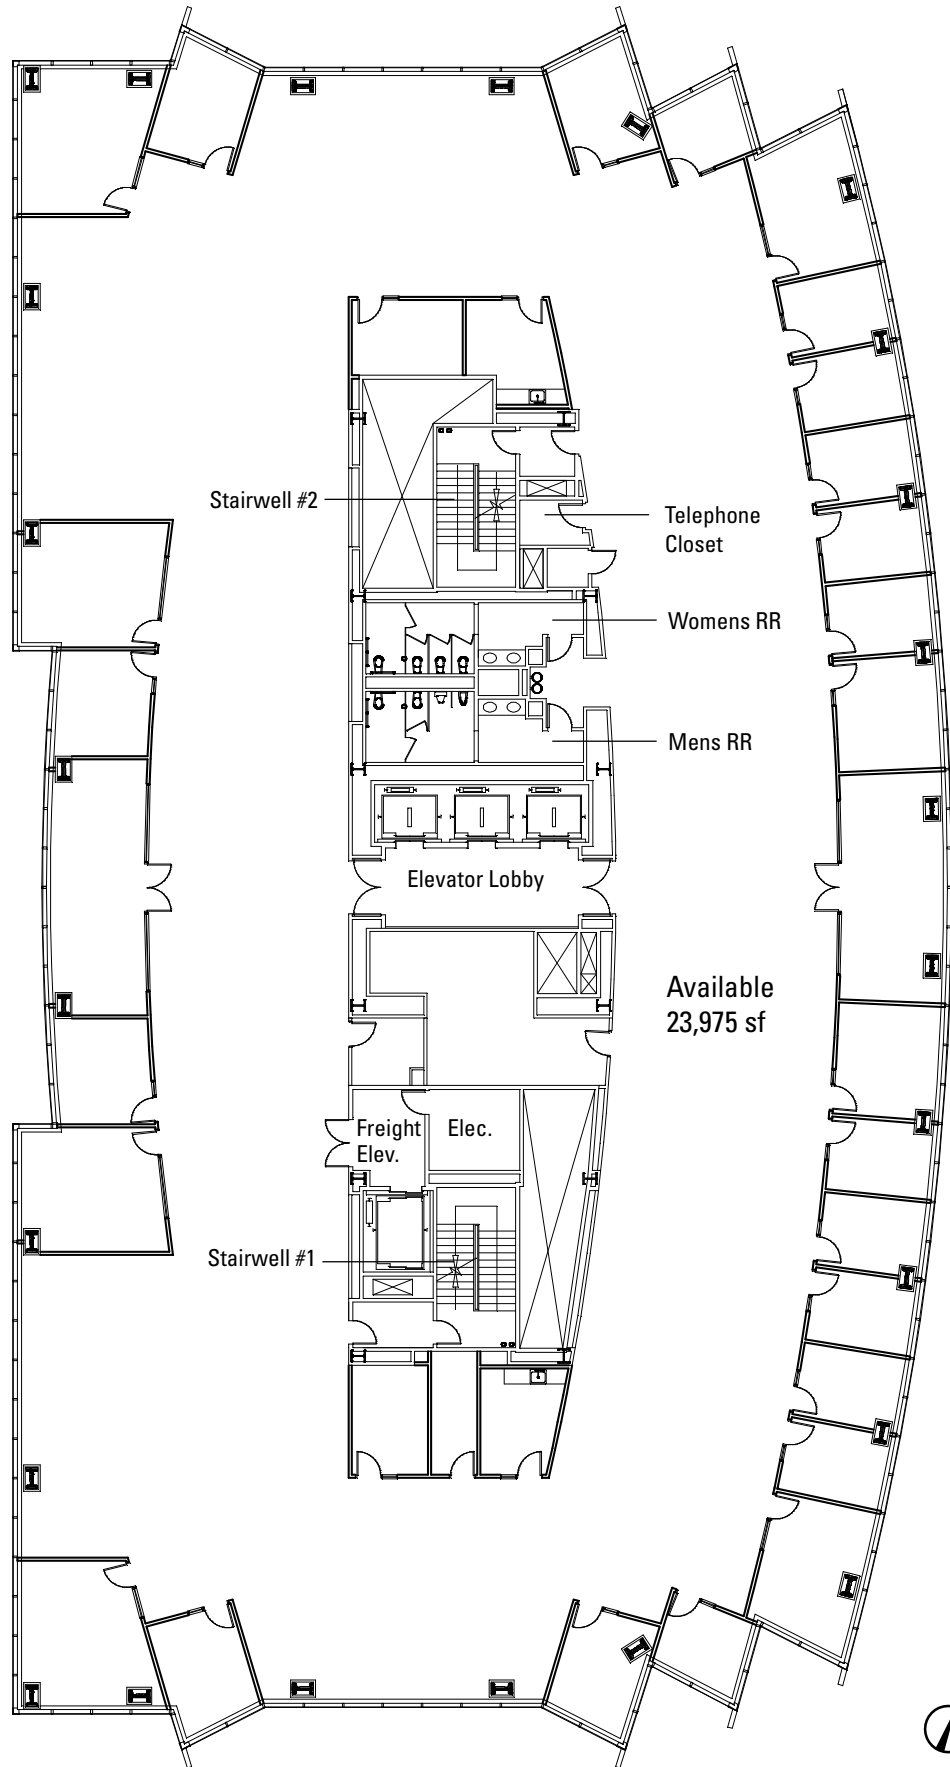

**2100**  
**POWELL**  
EMERYVILLE



**Hines**