


FLOOR 1 : Demising Wall Plan




2100
POWELL
EMERYVILLE

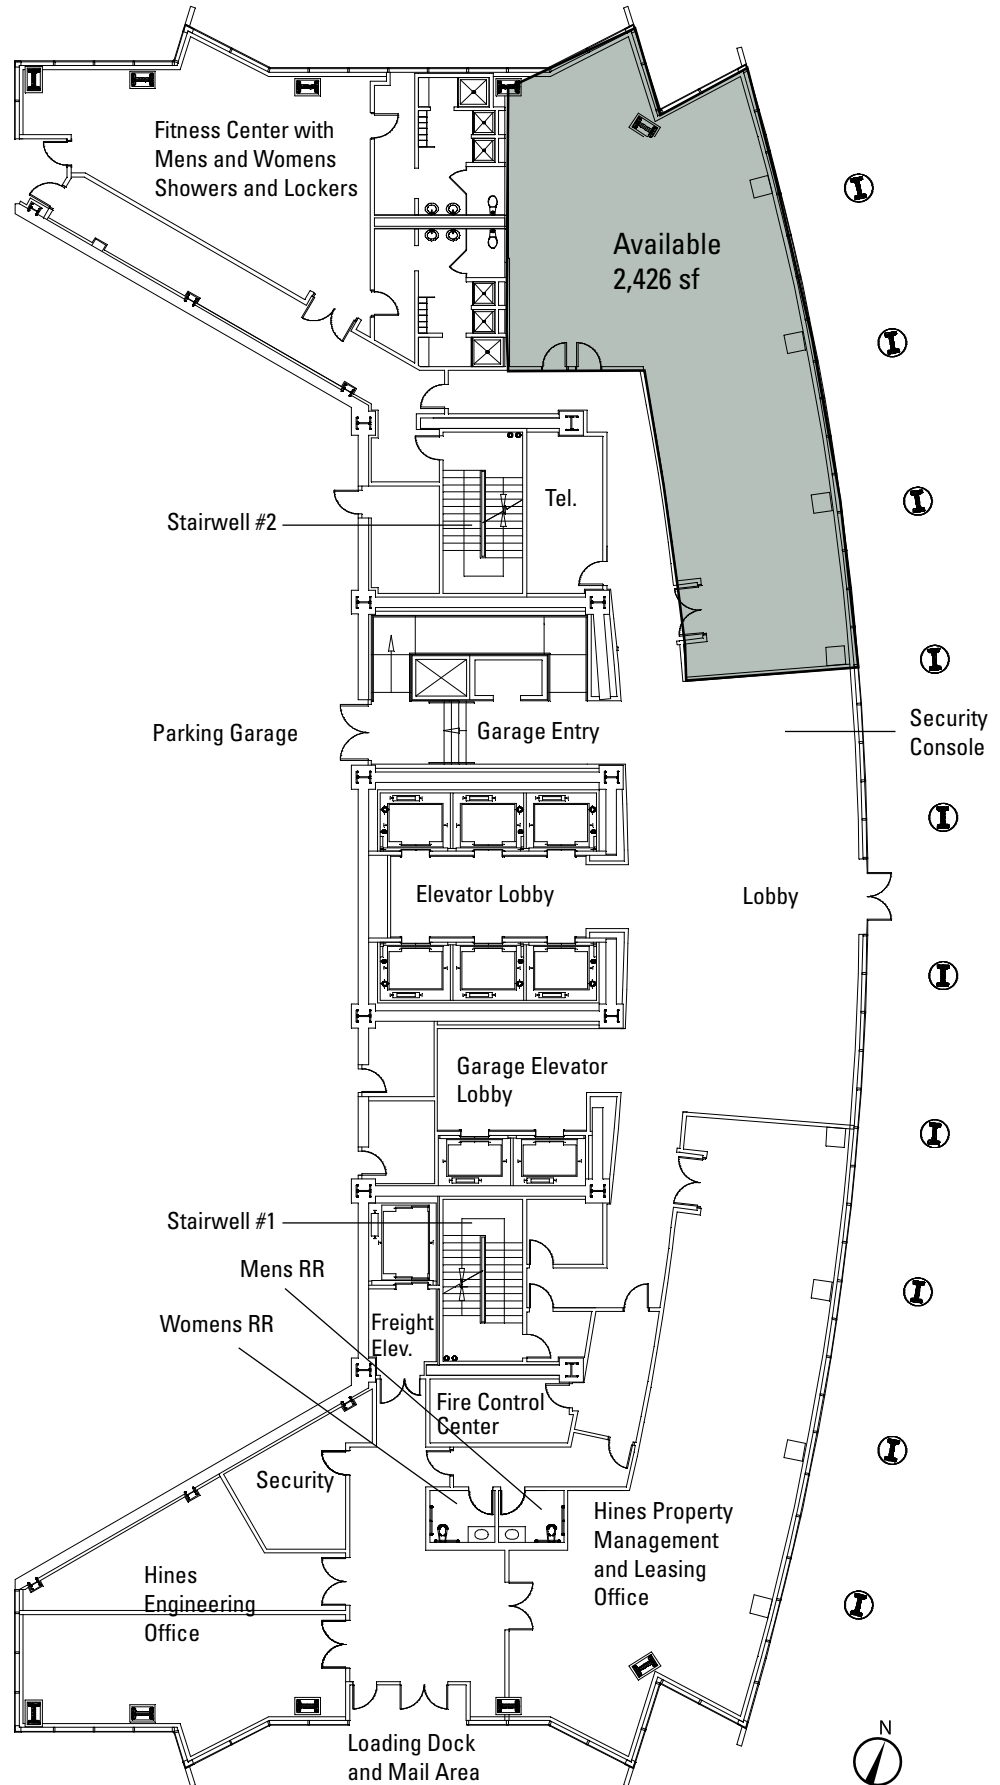

Hines

FLOOR 1 : As Built Plan

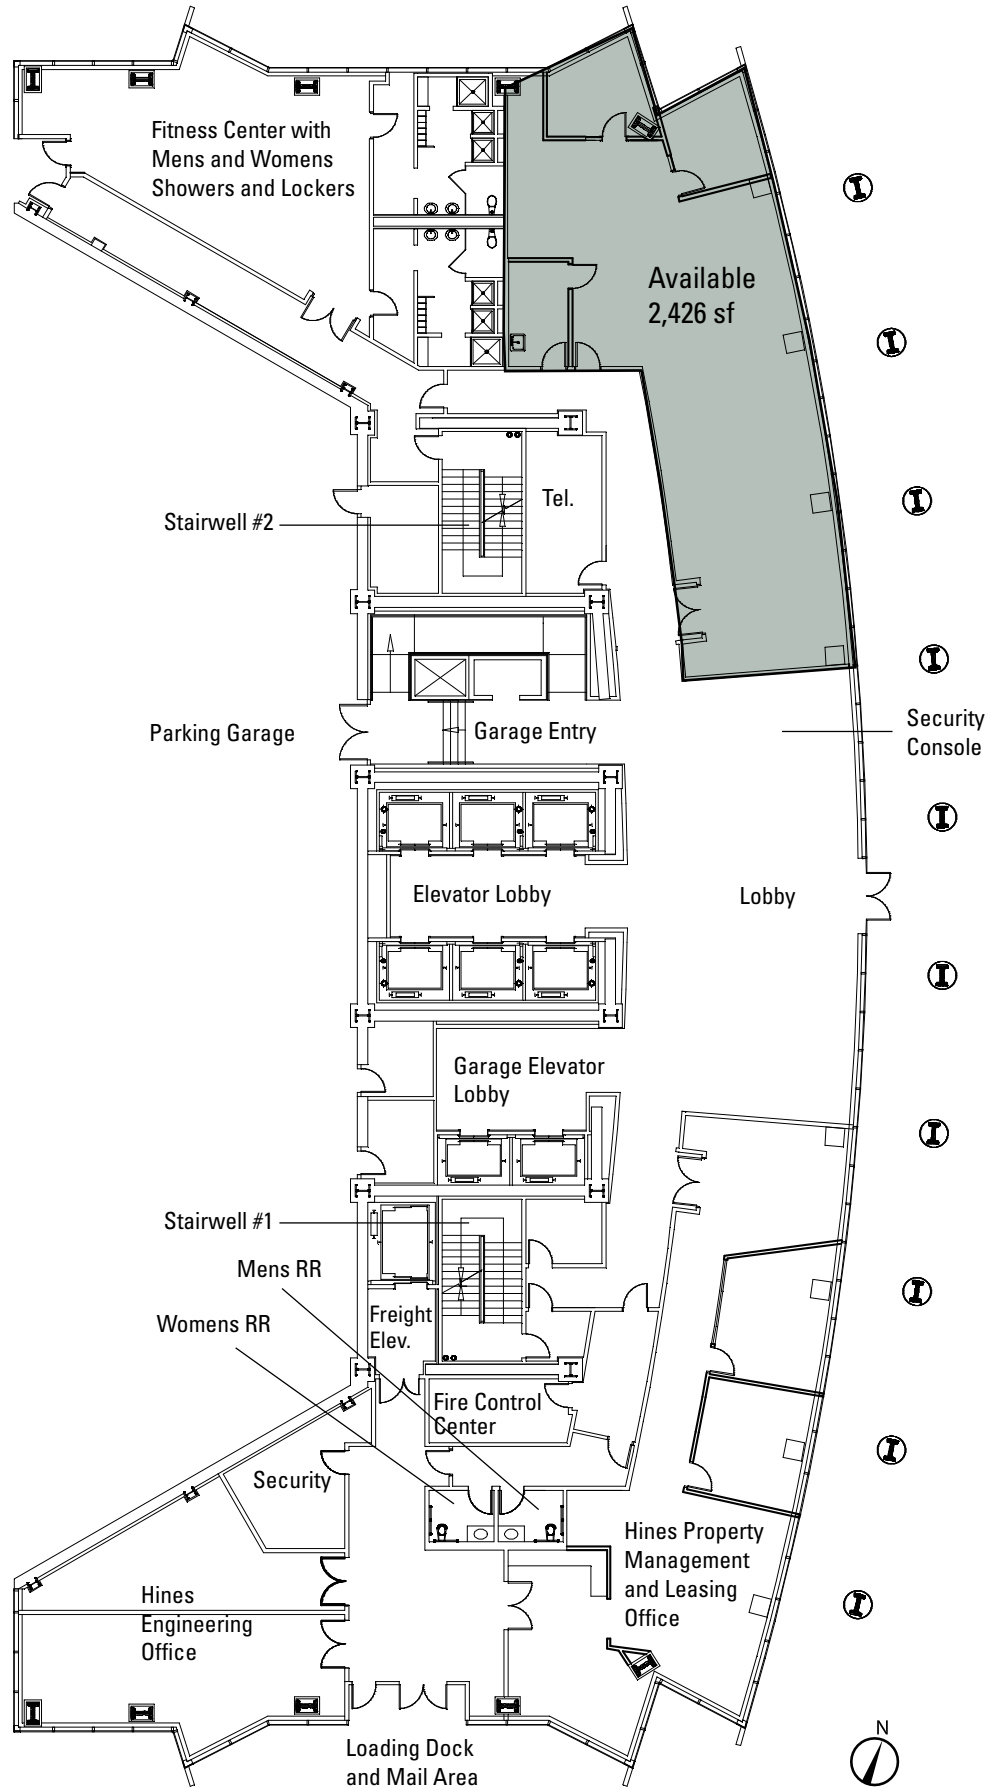

2100
POWELL
EMERYVILLE



Hines