


FLOOR 3




2100
POWELL
EMERYVILLE

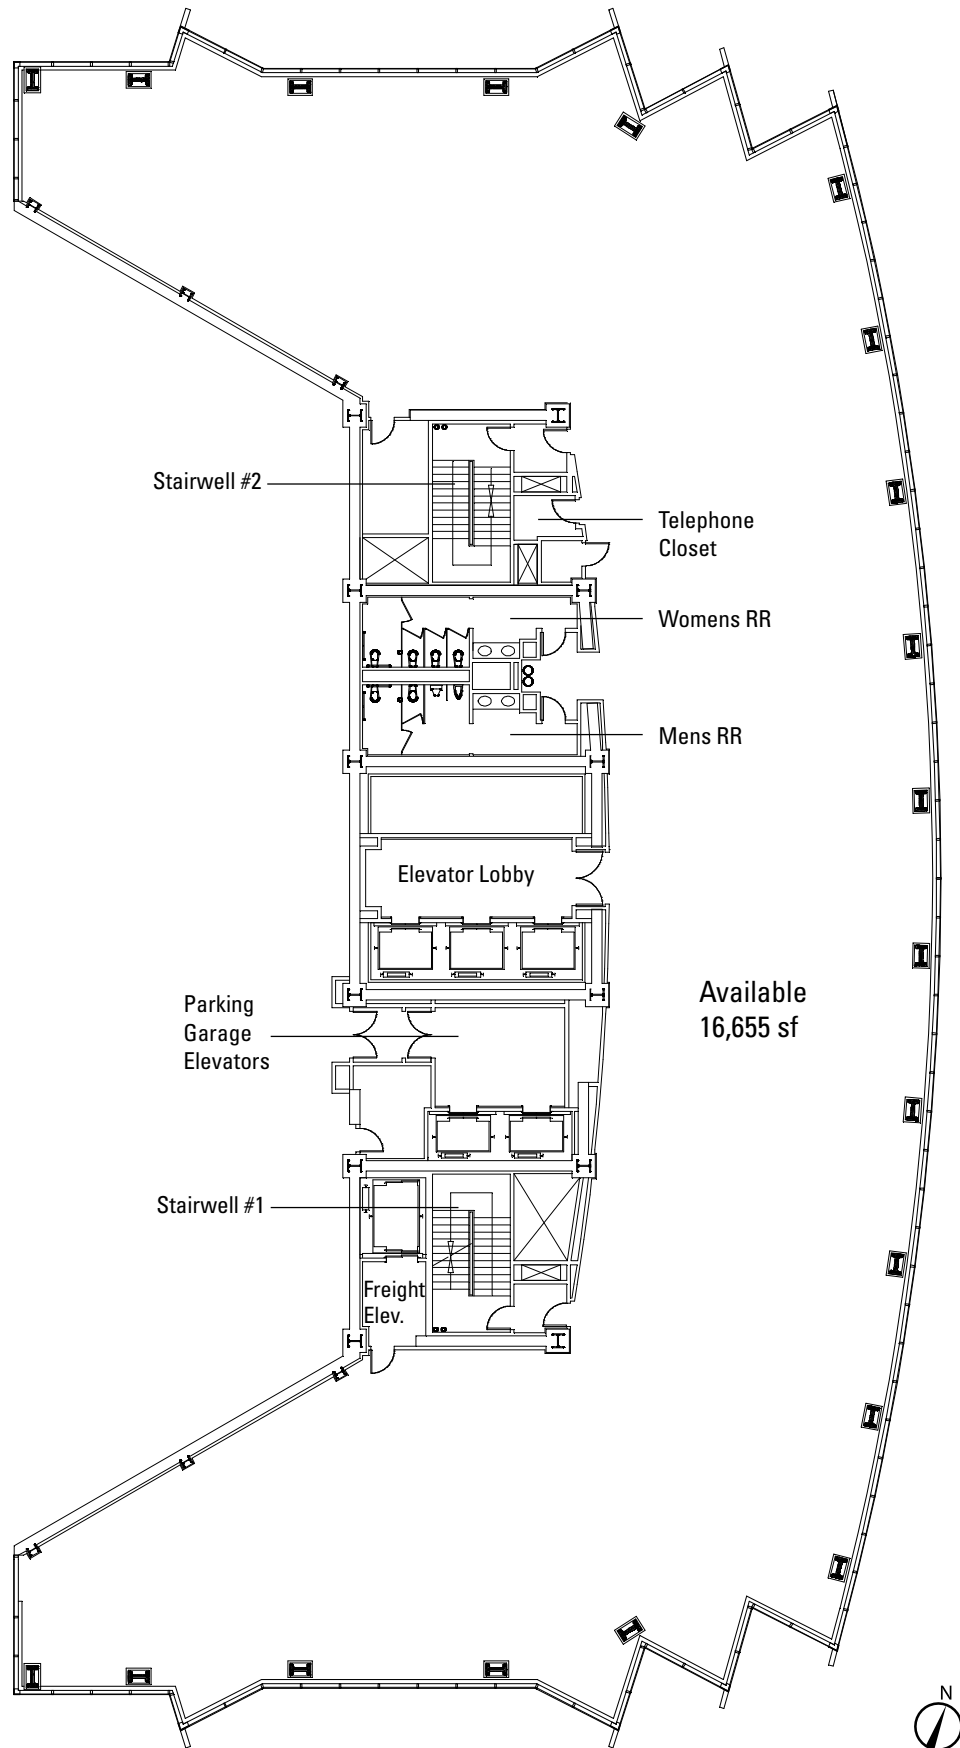

Hines

FLOOR 3 : As Built Plan

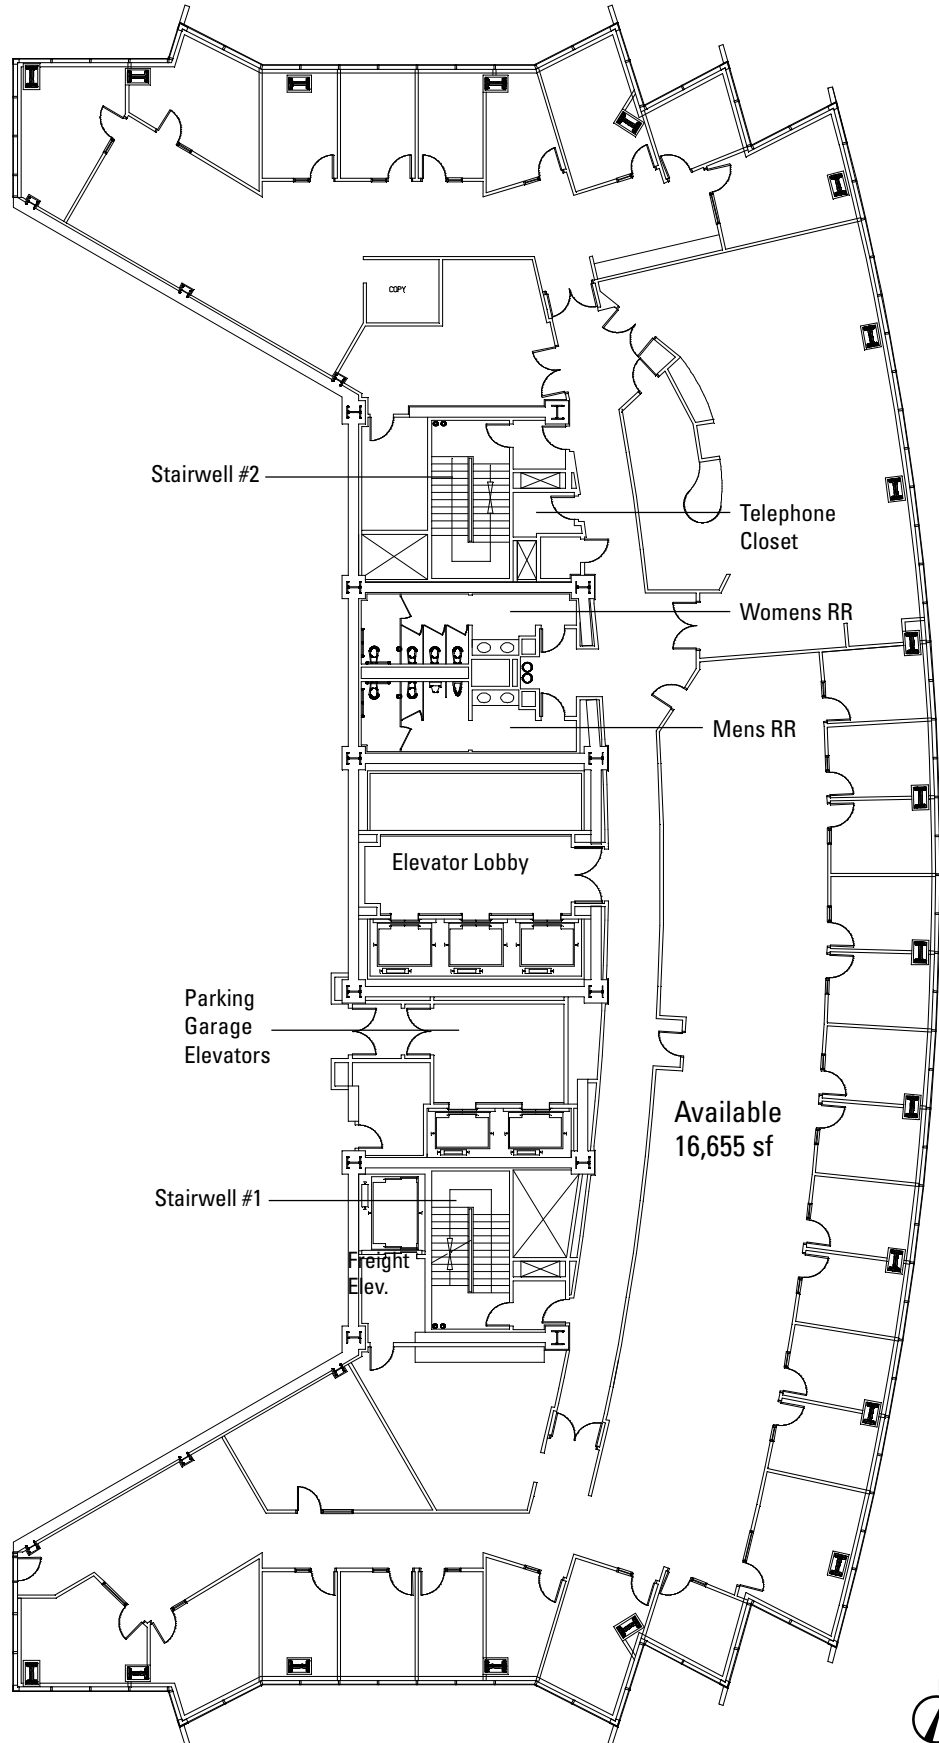

2100
POWELL
EMERYVILLE



Hines

