


FLOOR 4

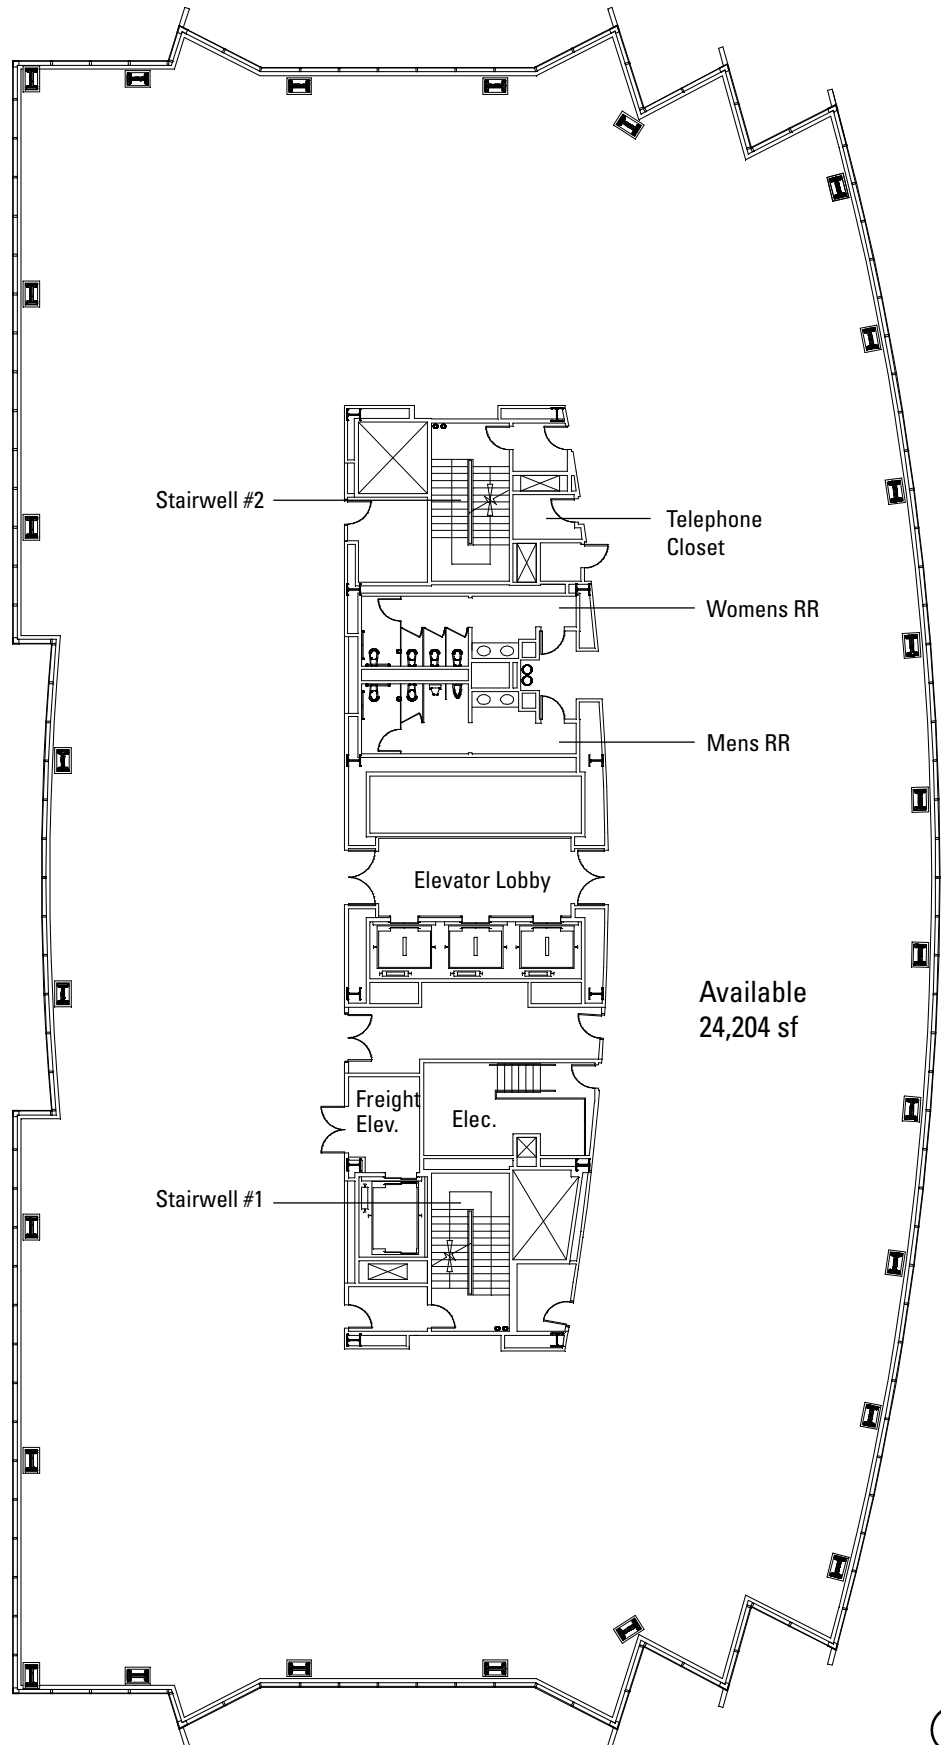

Stairwell #2

Telephone Closet

Womens RR

Mens RR

Elevator Lobby

Available
24,204 sf

Stairwell #1

Freight Elev.

Elec.




2100
POWELL
EMERYVILLE



Hines

FLOOR 4 : As Built Plan

Available
24,204 sf

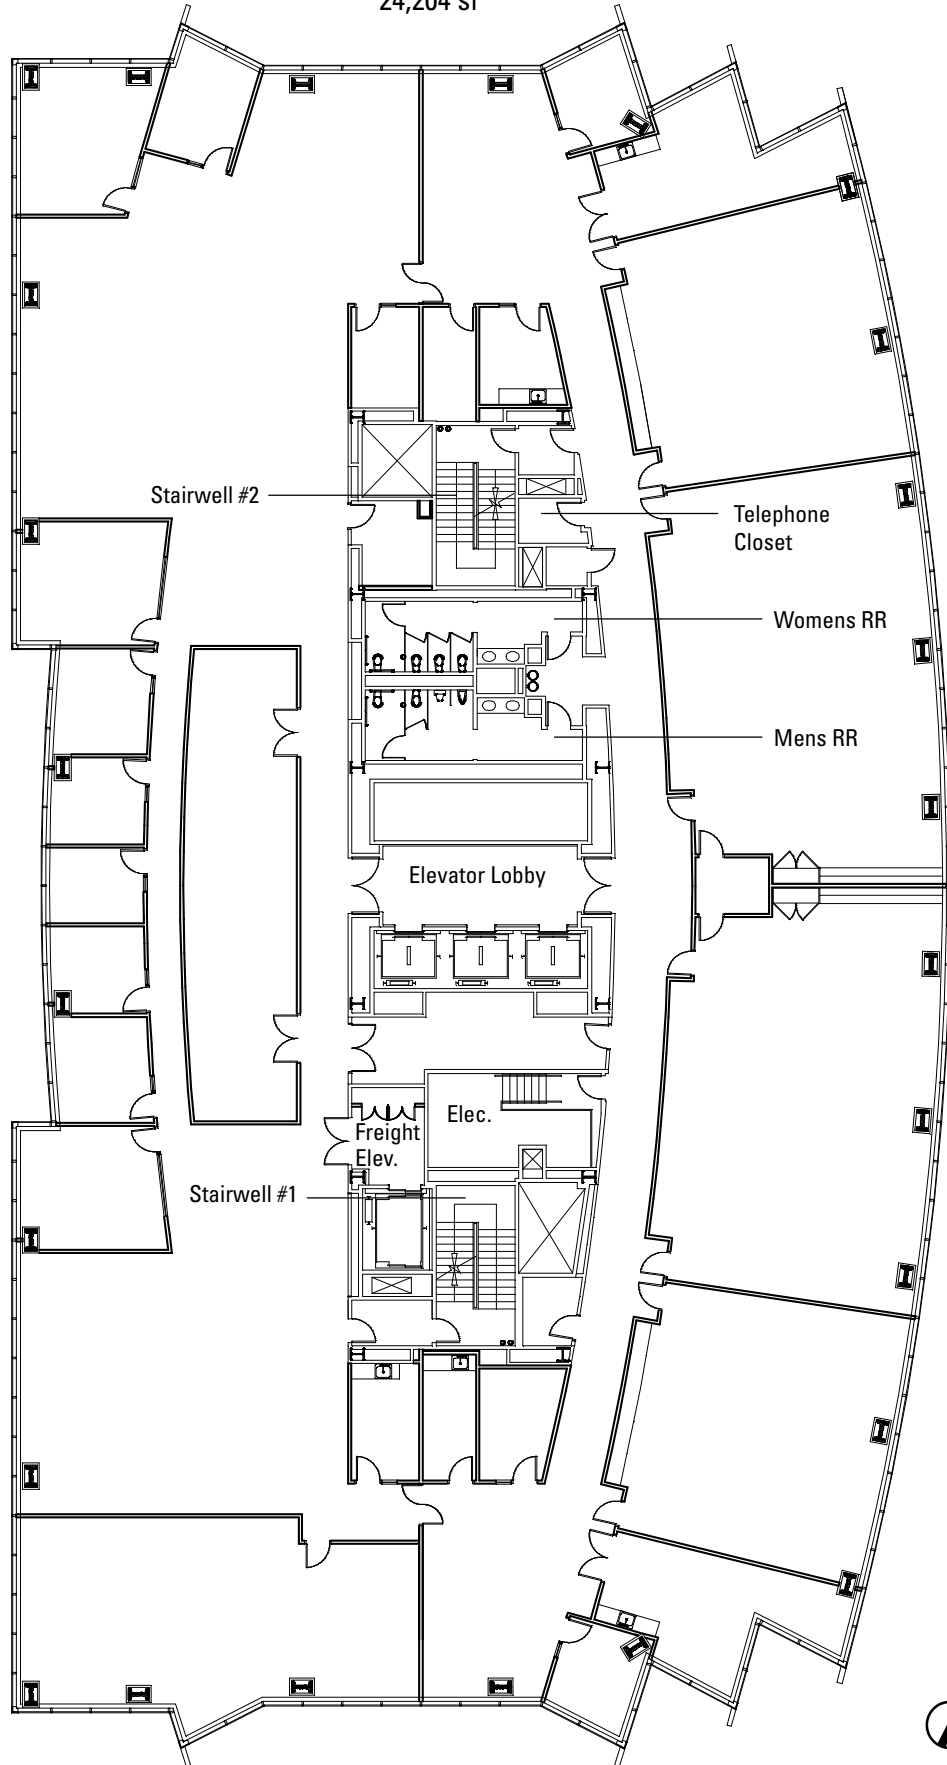

2100
POWELL
EMERYVILLE



Hines

