


FLOOR 6




2100
POWELL
EMERYVILLE

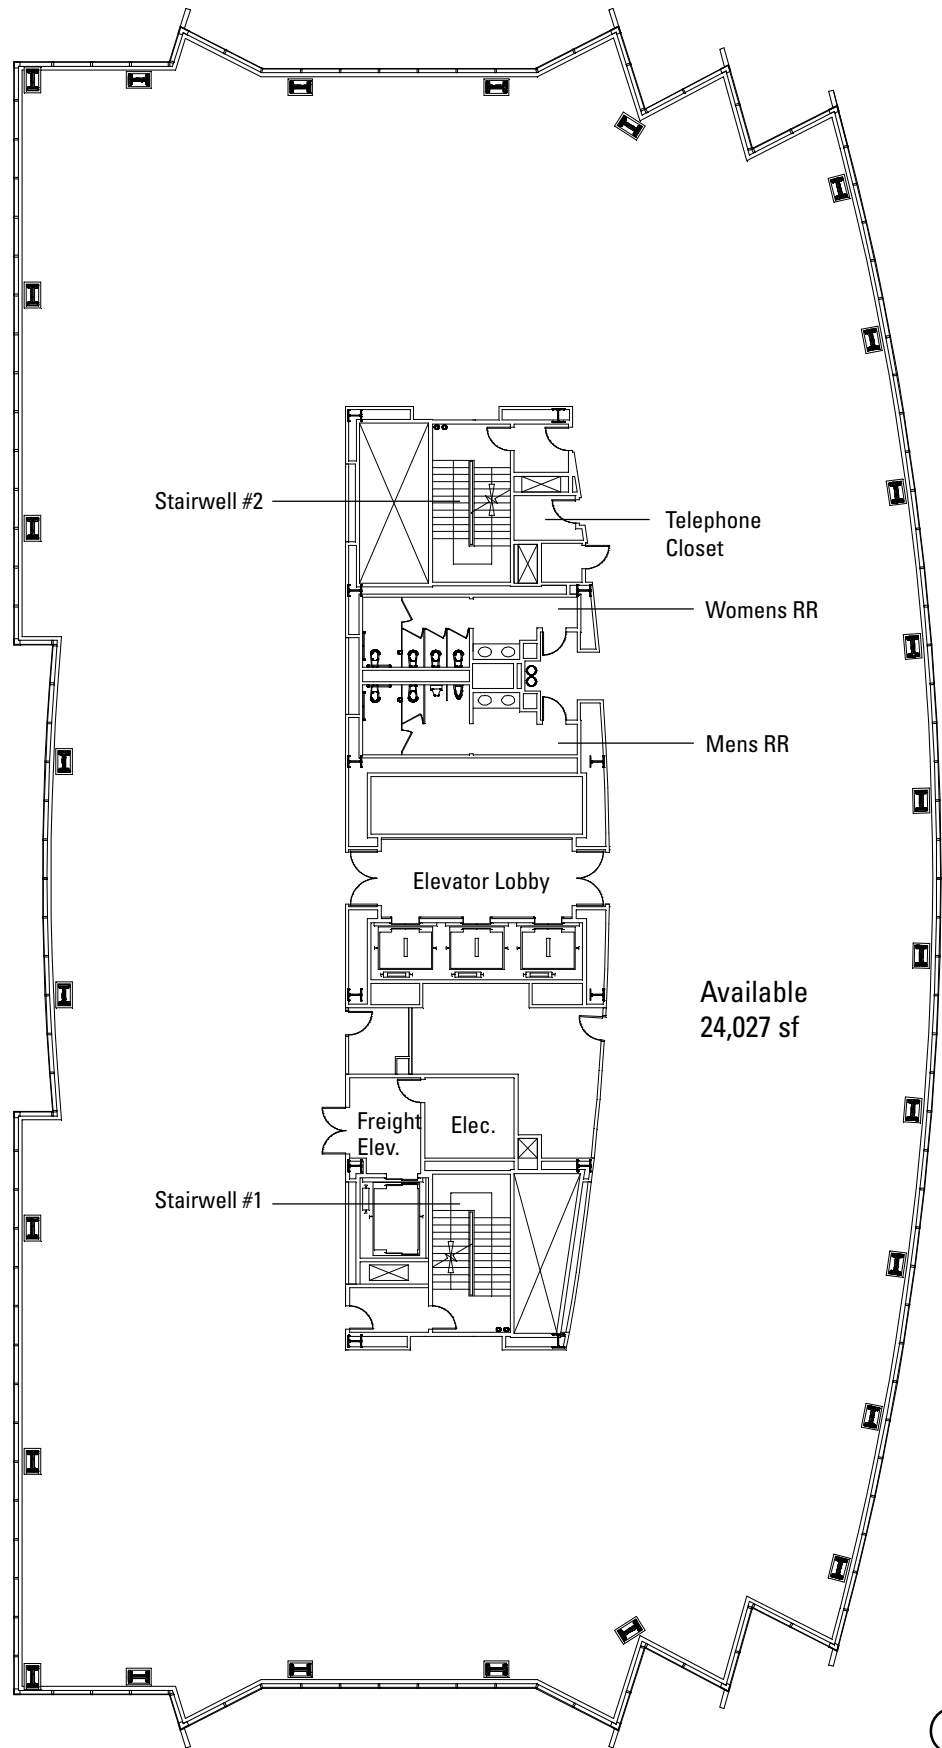

Hines

FLOOR 6 : As Built Plan

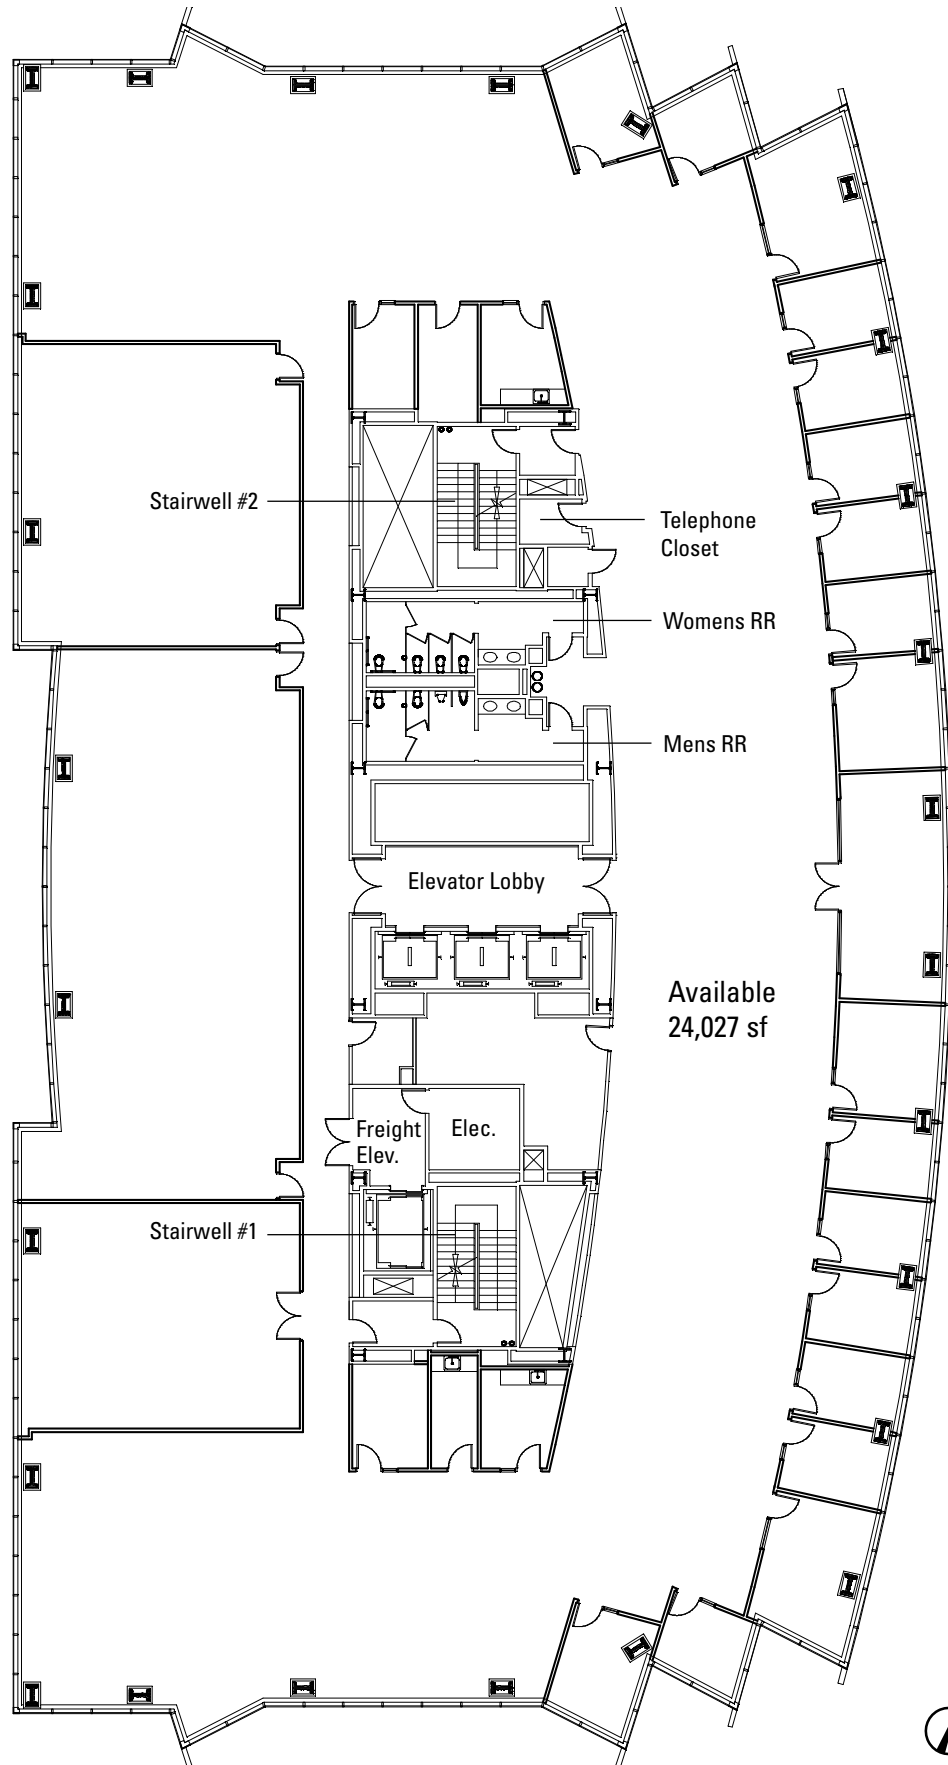

2100
POWELL
EMERYVILLE



Hines