


FLOOR 8

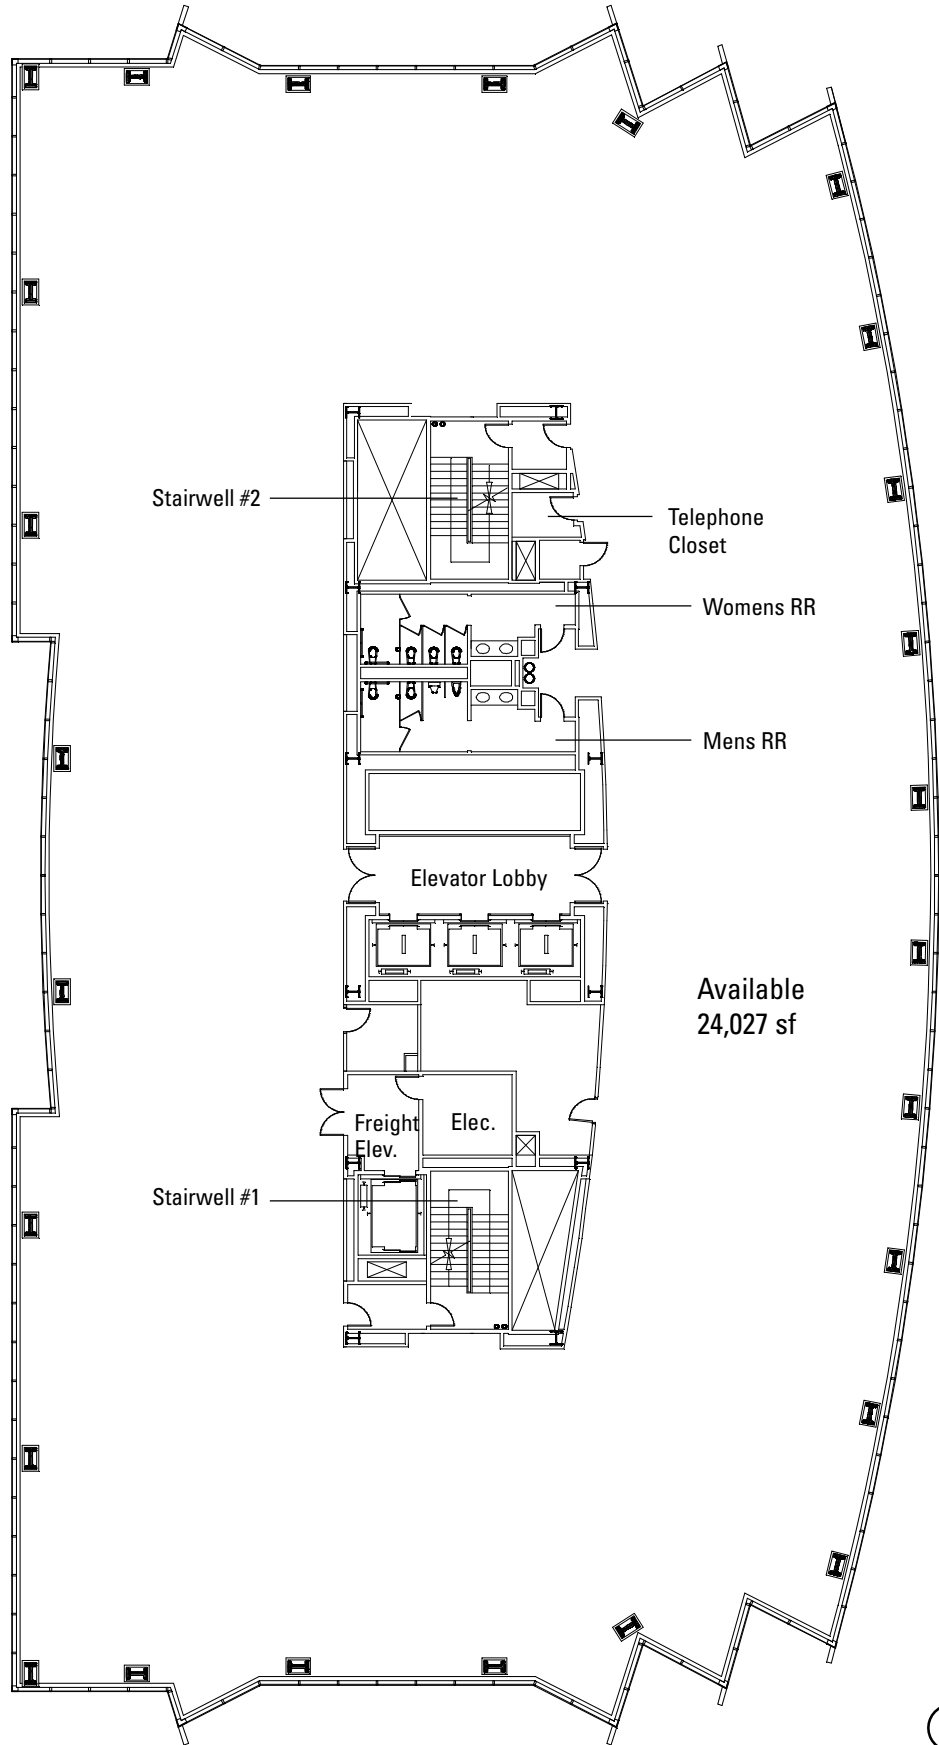

Stairwell #2

Telephone Closet

Womens RR

Mens RR

Elevator Lobby

Available
24,027 sf

Stairwell #1

Freight Elev.

Elec.




2100
POWELL
EMERYVILLE



Hines

FLOOR 8 : As Built Plan

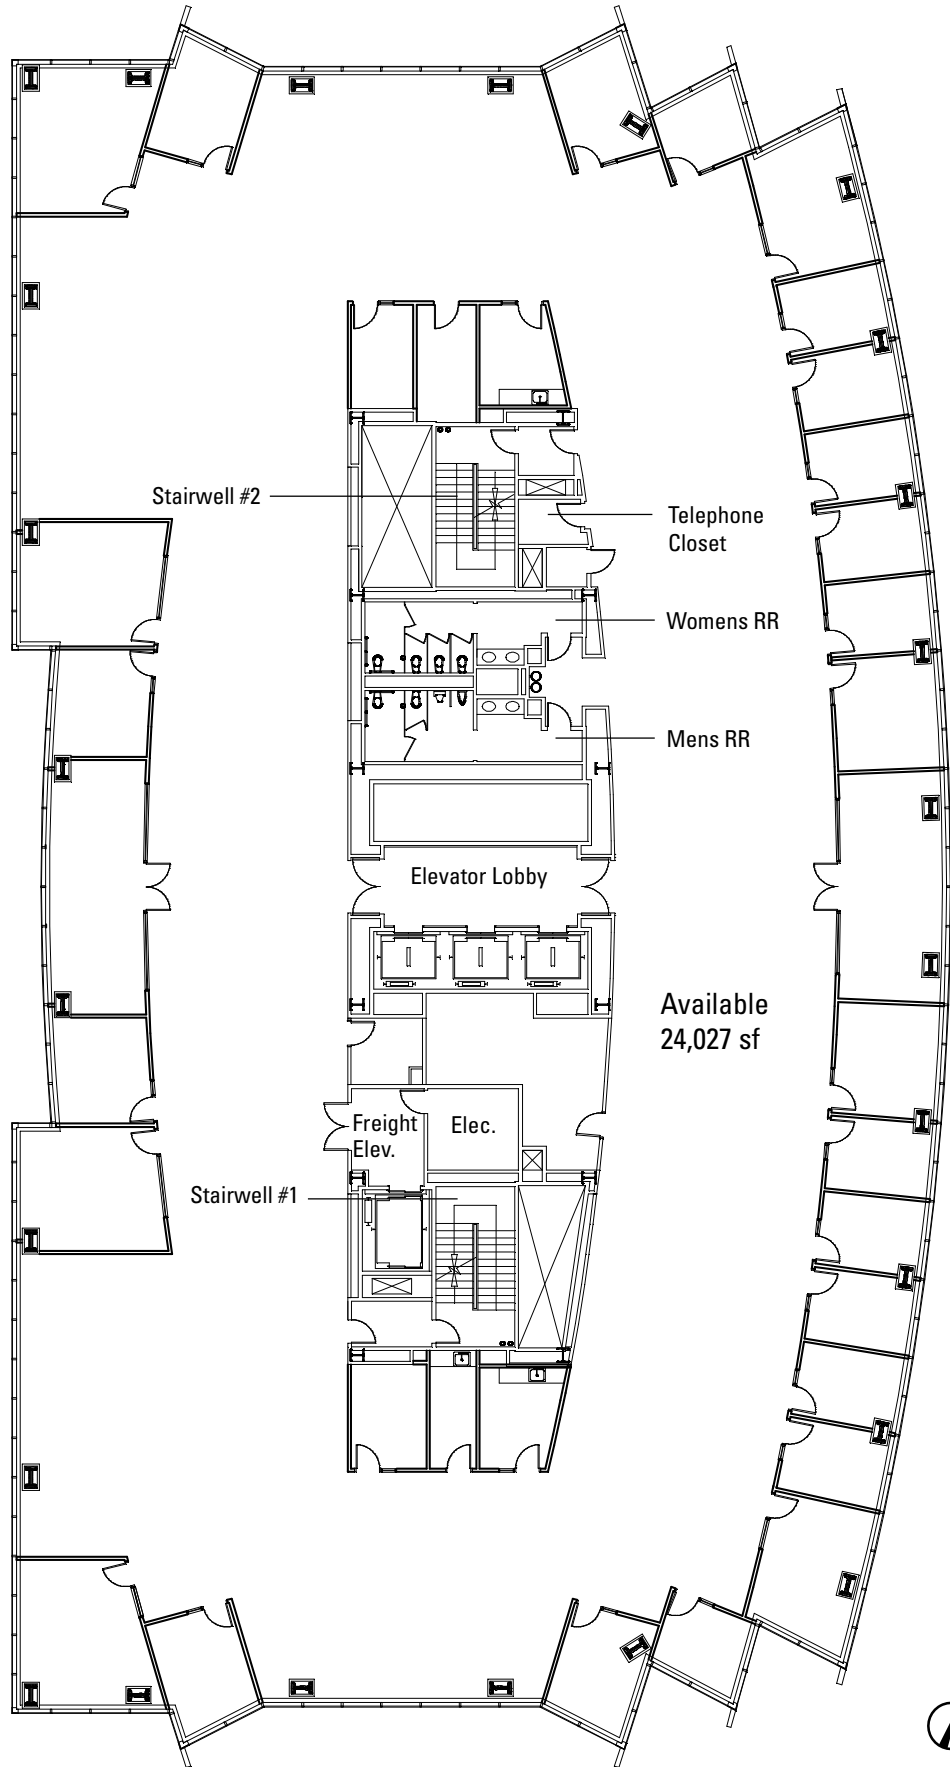

Stairwell #2

Telephone Closet

Womens RR

Mens RR

Elevator Lobby

Available
24,027 sf

Stairwell #1

Freight Elev.
Elec.



2100
POWELL
EMERYVILLE



Hines