


FLOOR 9




2100
POWELL
EMERYVILLE

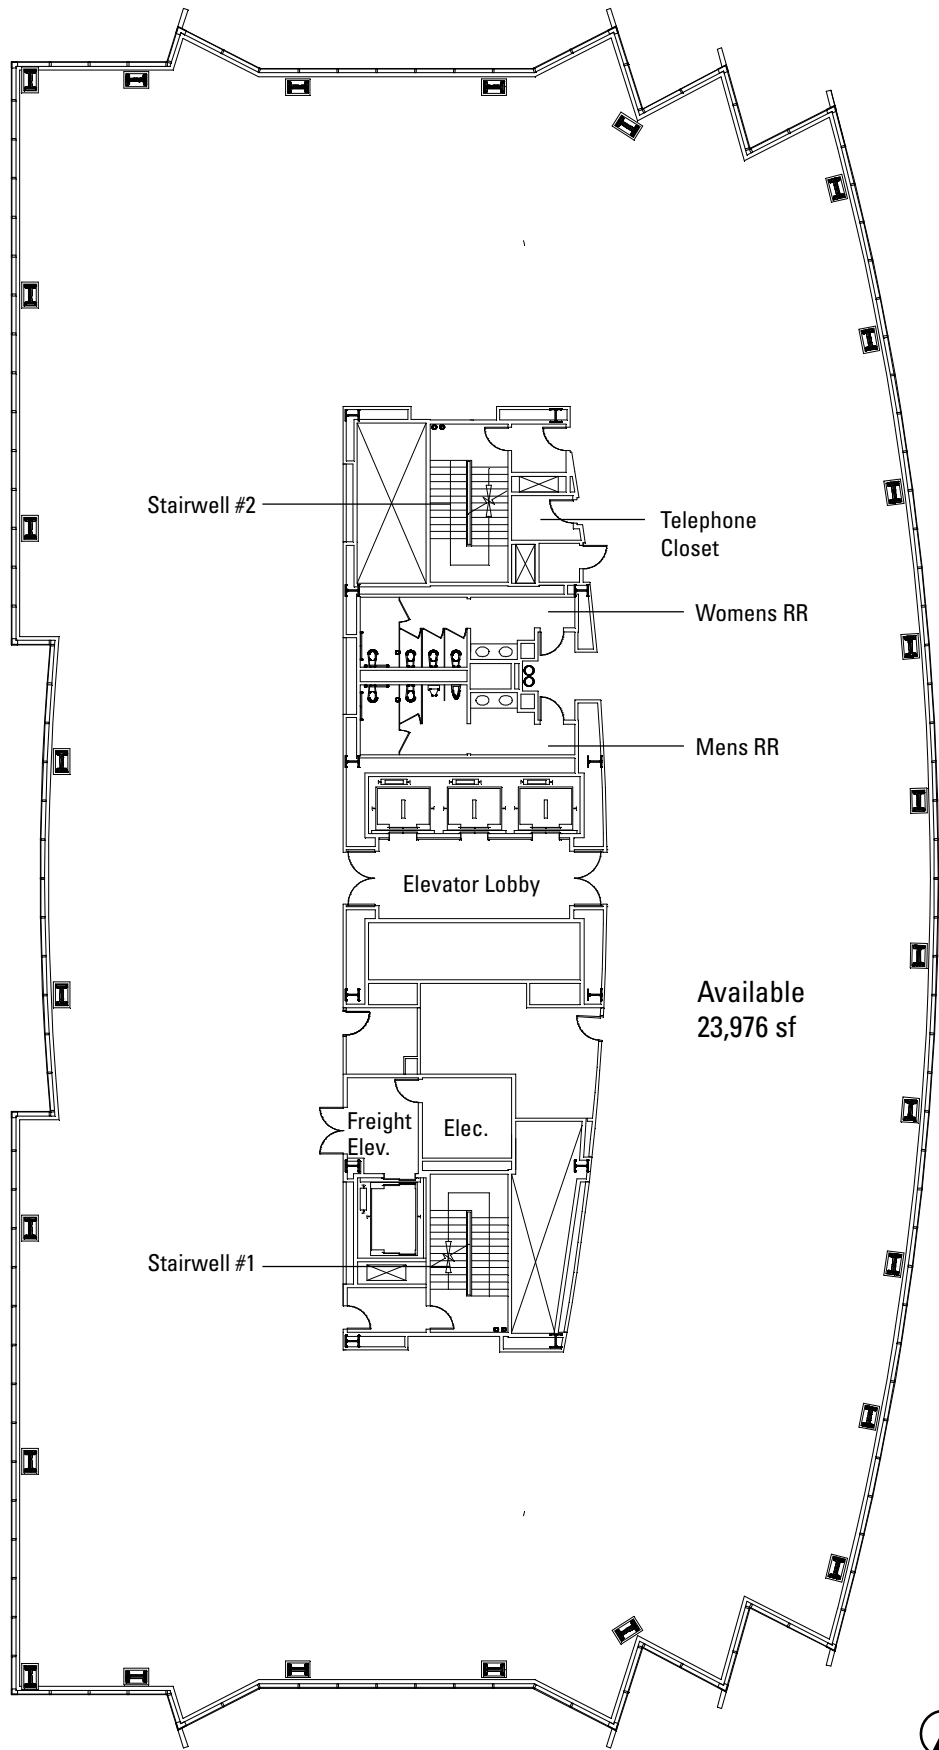

Hines

FLOOR 9 : As Built Plan

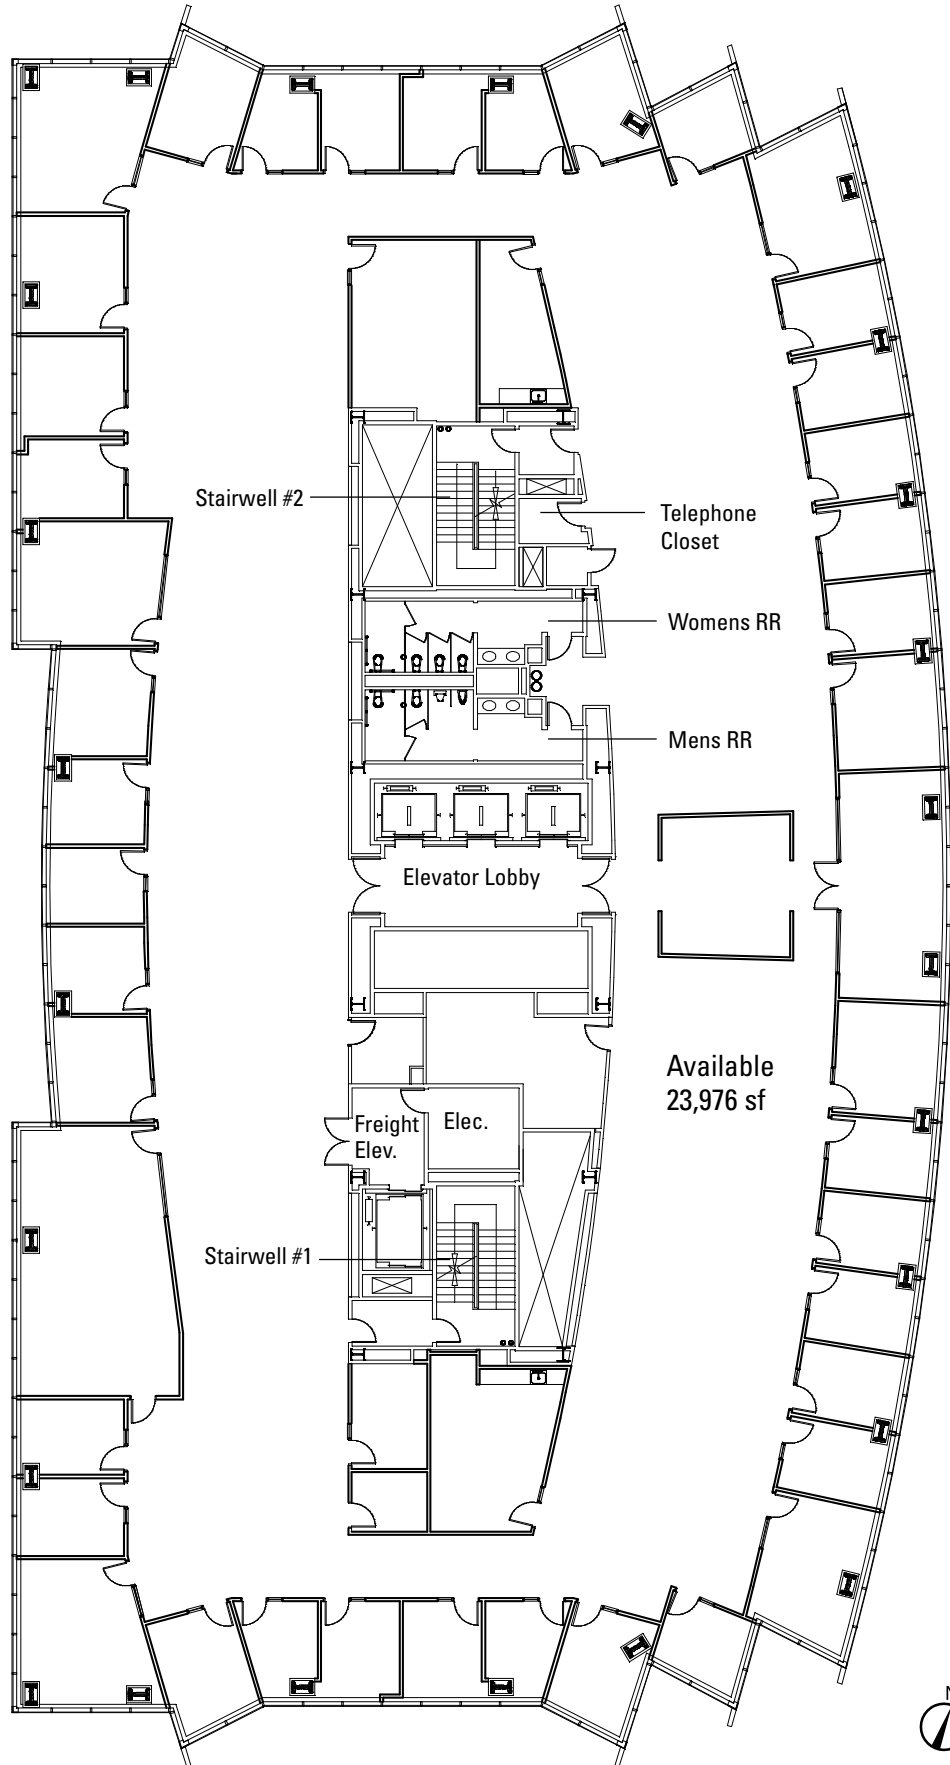

2100
POWELL
EMERYVILLE



Hines

