


RIDDER PARK TECHNOLOGY CENTER

1717 FOX DRIVE ±20,000 SF - ±50,900 SF

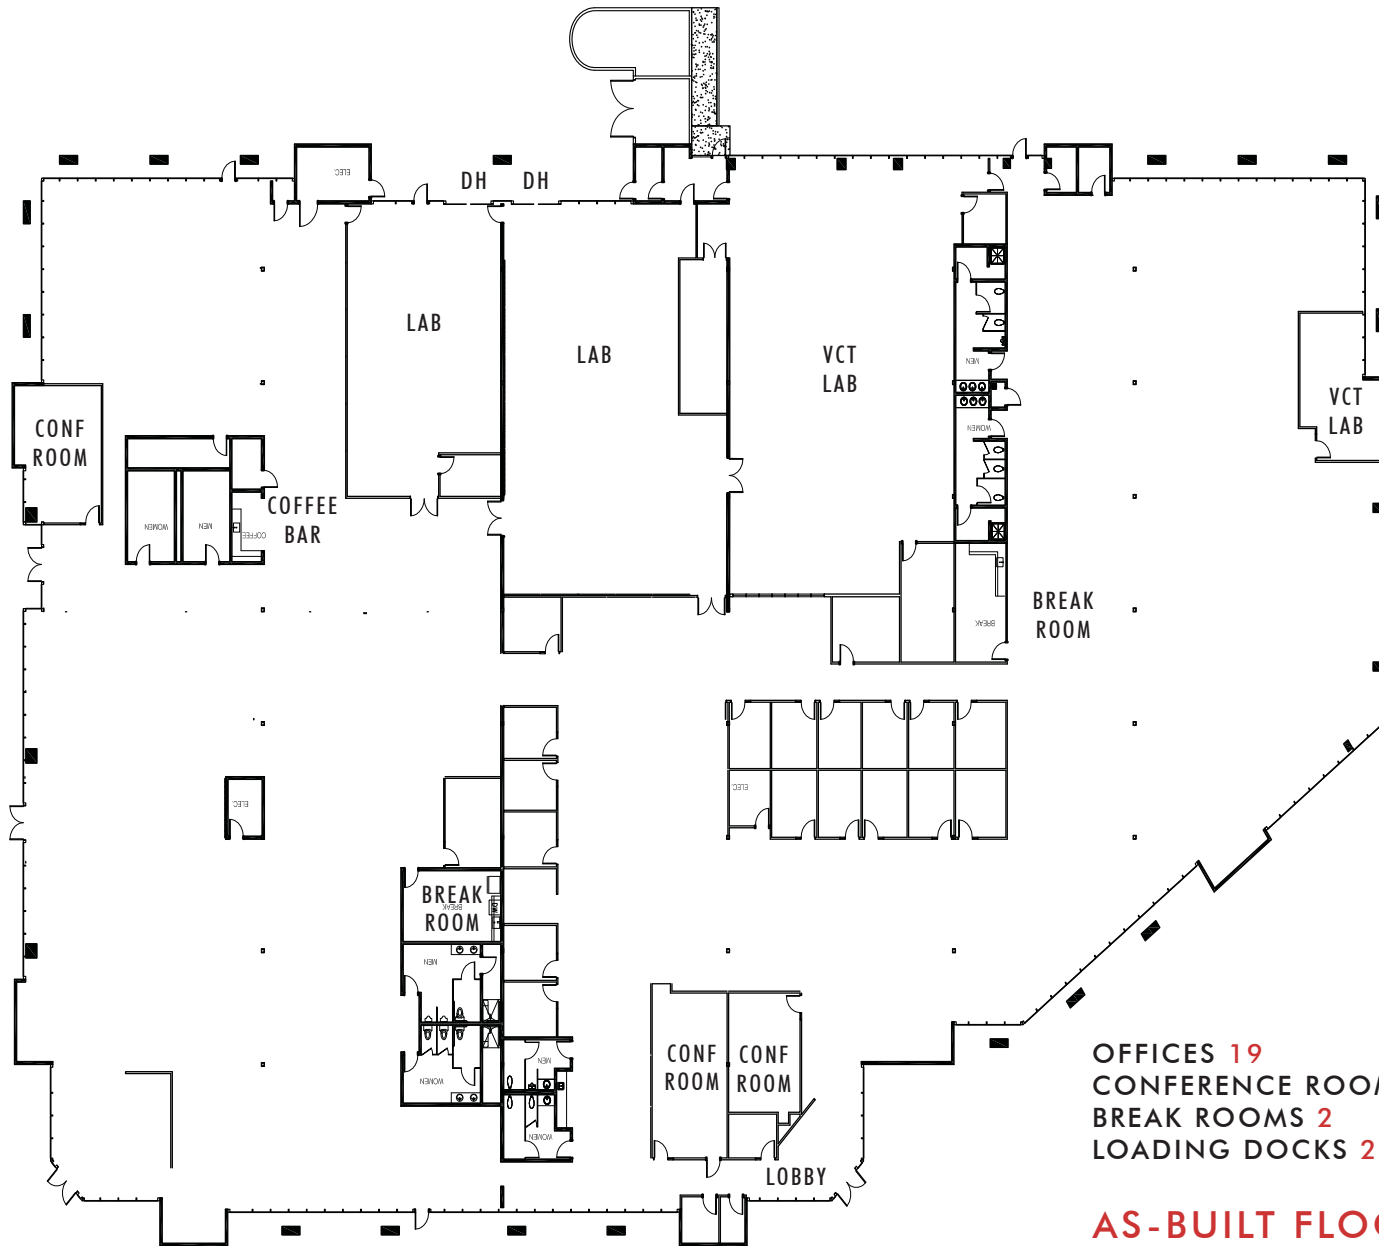

OFFICES 19
CONFERENCE ROOMS 3
BREAK ROOMS 2
LOADING DOCKS 2

**AS-BUILT FLOOR PLAN
(NOT TO SCALE)**

